


T. 38 S., R. 3 W., W.M.

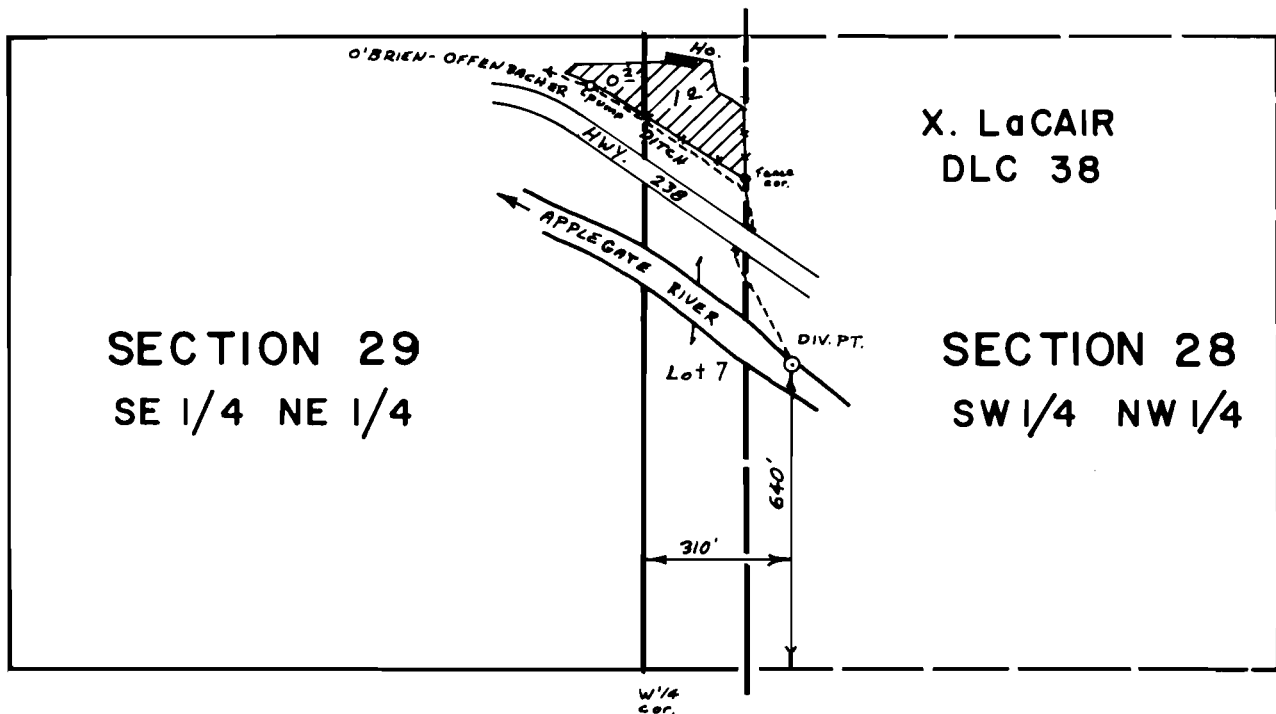

X. LaCAIR
DLC 38

SECTION 29
SE 1/4 NE 1/4

SECTION 28
SW 1/4 NW 1/4

Scale 1" = 400'

FINAL PROOF SURVEY
UNDER

Application No. **53331**... Permit No. **39572**...
IN NAME OF

.....**RICK A. JACKIE L. FLORY**.....

Surveyed **MAY 11, 1979**, by **B. R. SUND**.....