


T. 39 S., R. 4 W., W.M.

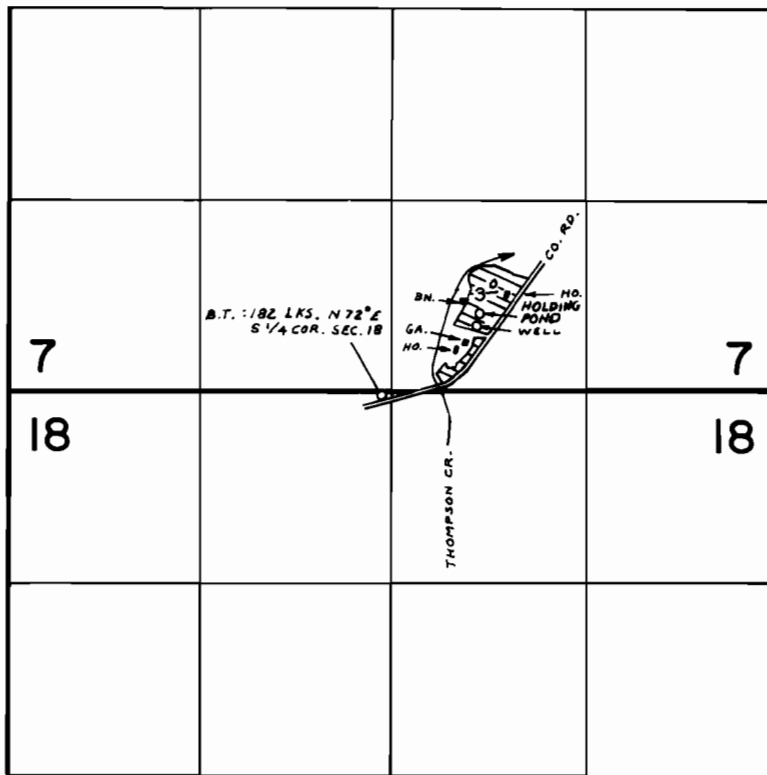

WELL LOC. : 450' N. $\frac{1}{2}$ 570' E. FROM S 1/4 COR. SEC. 7

FINAL PROOF SURVEY
UNDER

Application No. G-6982 Permit No. G-6489
IN NAME OF

LESLIE E. HILL

Surveyed JUN. 20 1978 by B. SUND