


T.39S., R.7 W., W.M.

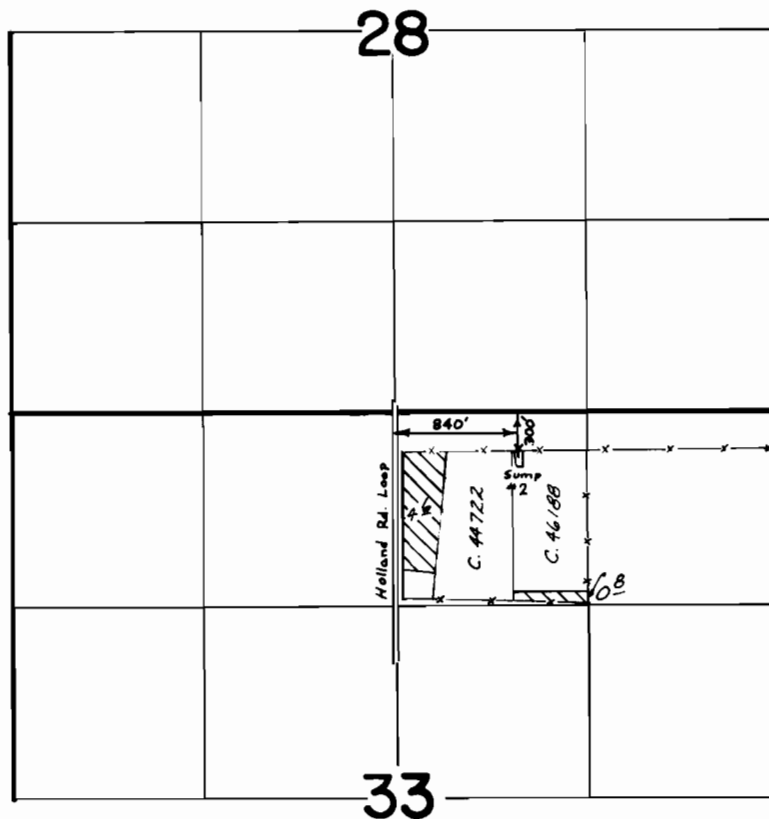

Scale 4"=1 mile

FINAL PROOF SURVEY
UNDER

Application No. G-8874 Permit No. G-8253
IN NAME OF

RICHARD & SHIRLEY HODDER

Surveyed April 29, 1980, by B.R. SUND