


T18S. R2W. W.M.

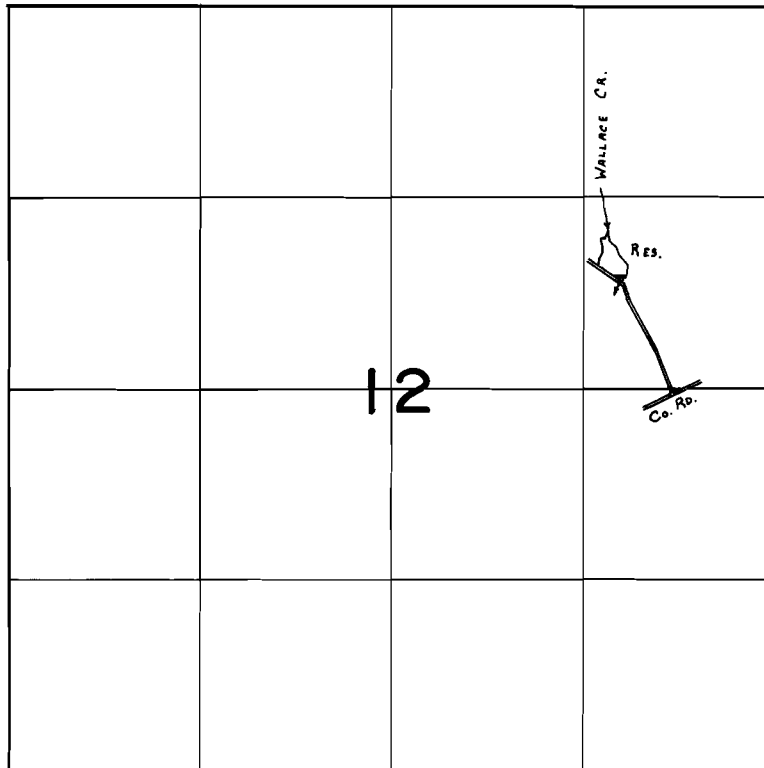

DAM Loc: 1860' S. & 1050' W. fr. N.E. Cor. Sec. 12.

FINAL PROOF SURVEY
UNDER

Application No. 62360 Permit No. 46517
R-50943 R-6197.....
IN NAME OF

.....CLINT DANKER.....

Surveyed June 19, 1980, by C. L. Hughes.....
July 14 1982 L. M. TOLL