


# T.18S.R.2W., W.M.

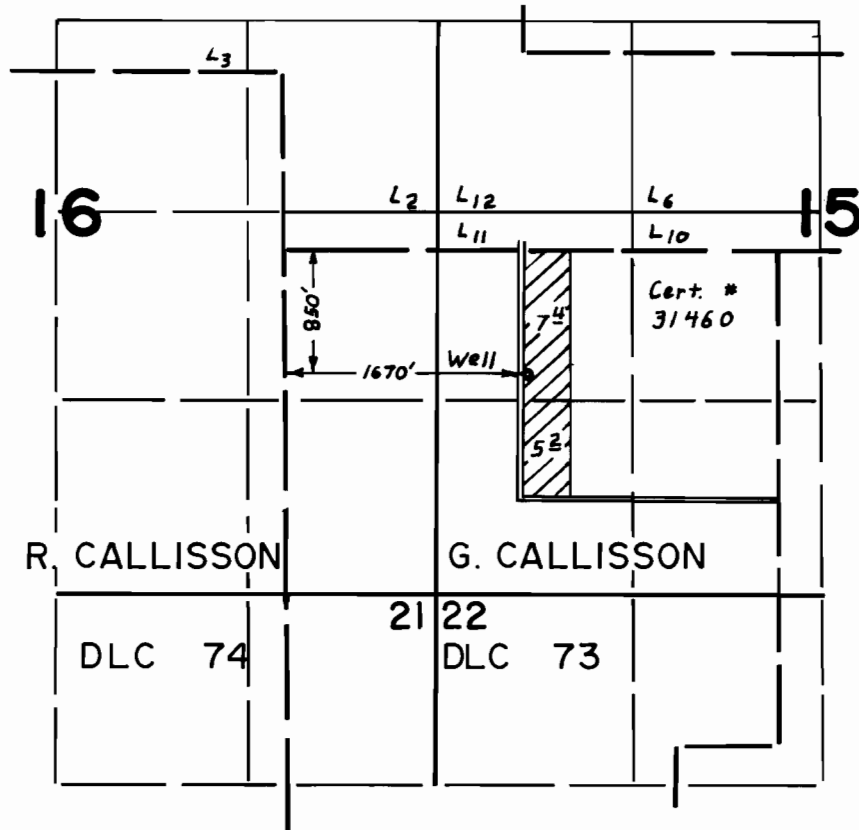

## FINAL PROOF SURVEY UNDER

Application No. G-7935. Permit No. G-7321...  
IN NAME OF

.....RODNEY CHASE.....

Surveyed MAY 18, 1978, by J.S. DONALDSON  
Sept. 14, 1981, by S. C. BROWN