


T.IIS. R. IW. W.M.

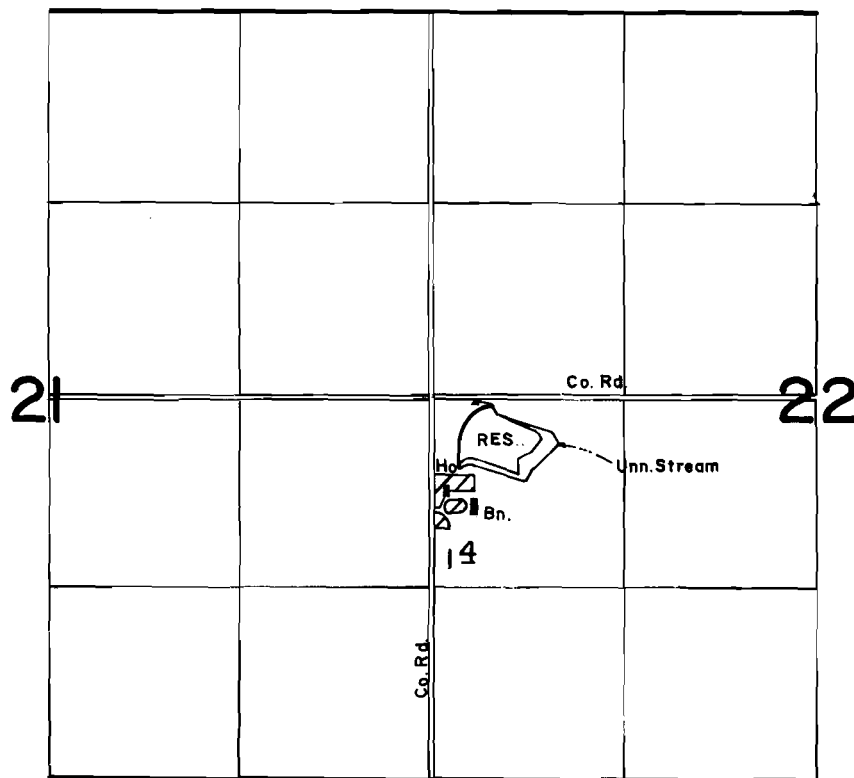

Div. Pl. Loc. - 50'S & 430'E from W 1/4 Cor. Sec. 22

FINAL PROOF SURVEY
UNDER

R-50665 R-6181
Application No. 50666. Permit No. 38276.....
IN NAME OF

LEIGH & ROSE E. SMITH.....

Surveyed Aug. 1..... 1979, by S.C. BROWN.....