


T.9S.,R.1E.,W.M.

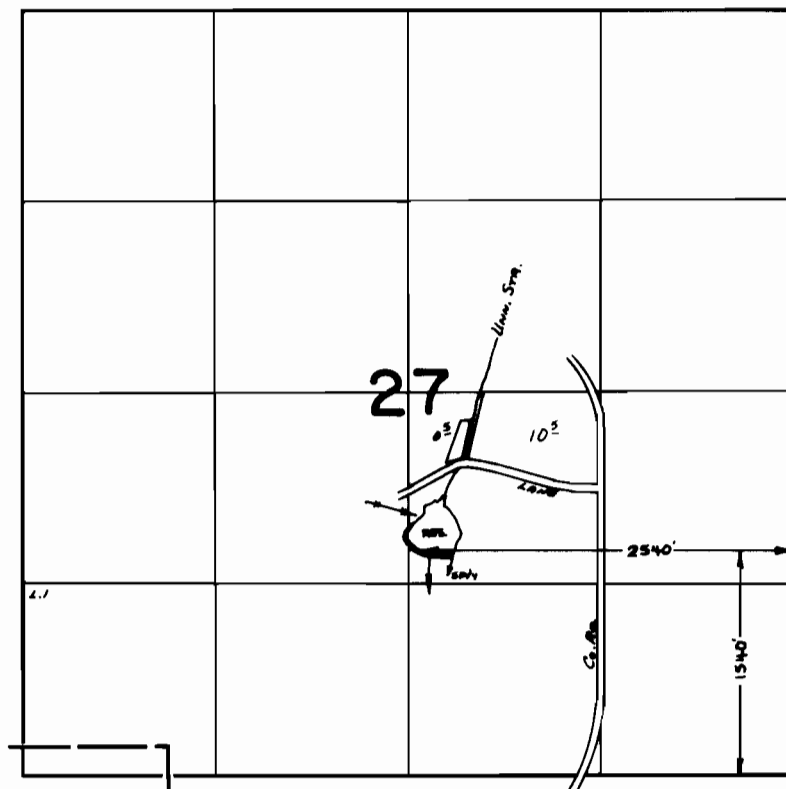

FINAL PROOF SURVEY
UNDER

R-57853 R-7769
Application No. 57854 Permit No. 43765
IN NAME OF

FRED LINDEMAN

Surveyed July 26, 1982, by L. M. TOLL