


T.10S.,R.2W.,W.M.

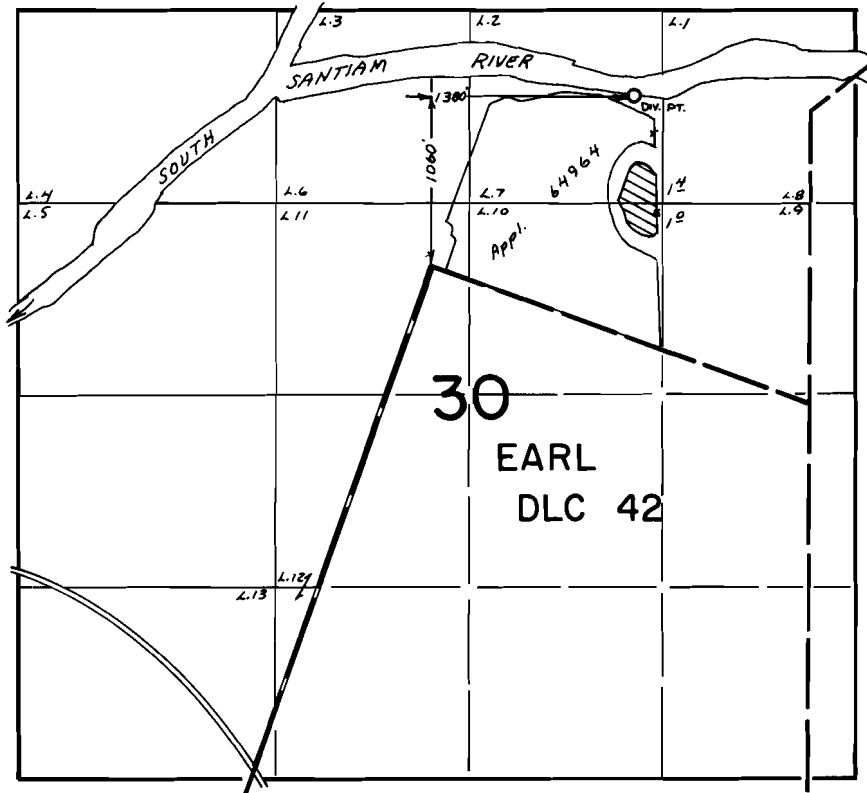

FINAL PROOF SURVEY UNDER

Application No. .57.788. Permit No. .43450....
IN NAME OF

.....TOM & NANCY VANASCHE.....

Surveyed July....7.... 19.82., by .L.M. TOLL.....