


T.12S., R. 4 W.W.M.

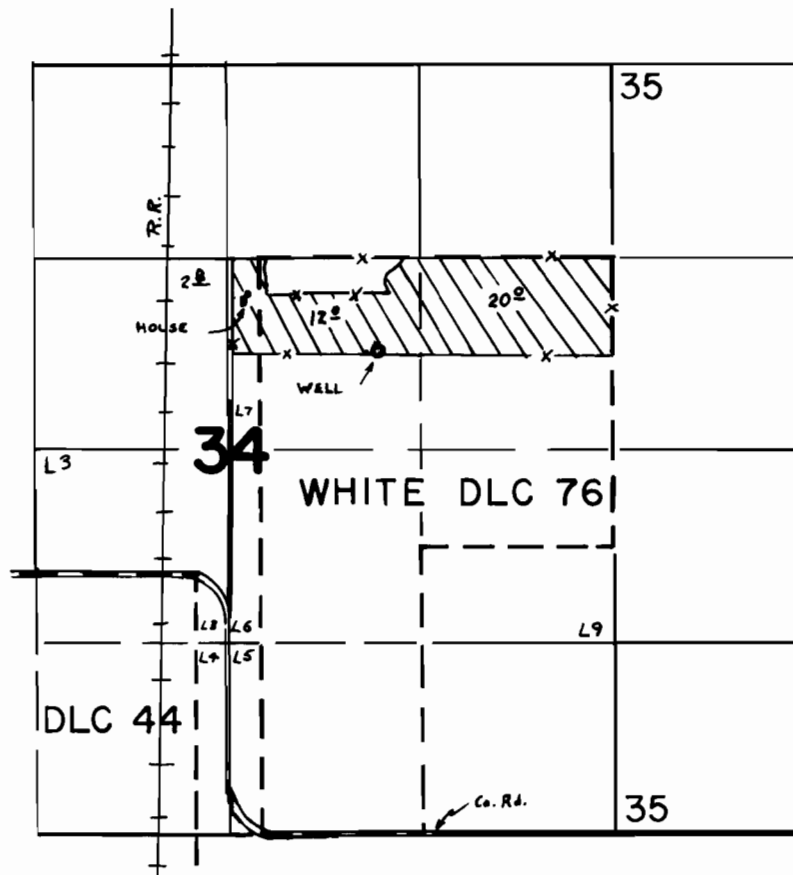

WELL LOCATED 640' S. & 1620' W. FROM NE COR. WHITE DLC 76

FINAL PROOF SURVEY
UNDER

Application No. G-6448 Permit No. G-6049
IN NAME OF

.....DONNA FAYE OHLING.....

Surveyed AUG. 5, 1977, by B.R. SUND.....