


T.9S. R.1W., W.M.

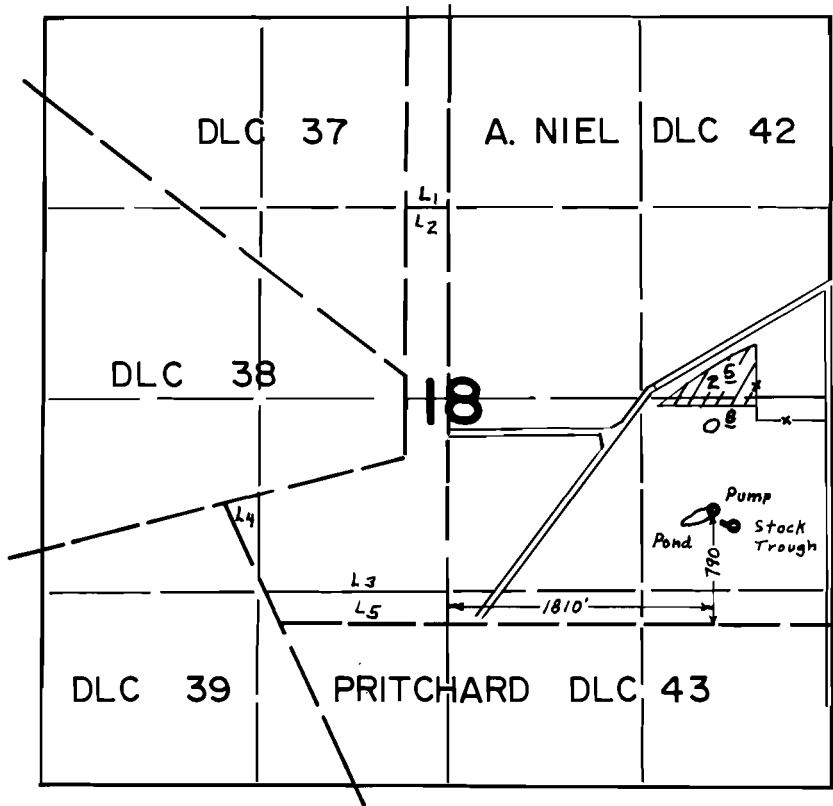

FINAL PROOF SURVEY UNDER

Application No. 554.73... Permit No. 42611.....
IN NAME OF

.....ROBERT G. THOMAS.....

Surveyed MAY 23, 1978, by S.P. APPELEGATE.