


T7S. RIW. WM.

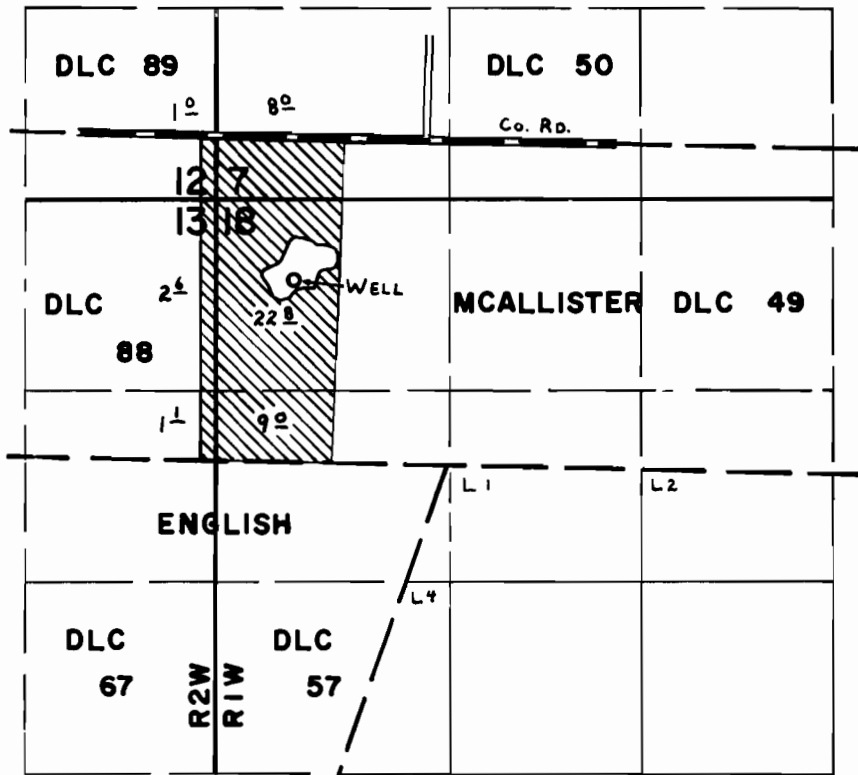

WELL LOC: 1270' N & 1050' W fr. NE COR ENGLISH DLC 57.

FINAL PROOF SURVEY UNDER

Application No. G-8000 Permit No. G-7576
IN NAME OF

WILLIAM GASH

Surveyed MAY 18 1978, by C. L. HUGHES