


T. 7S., R. 6W., W.M.

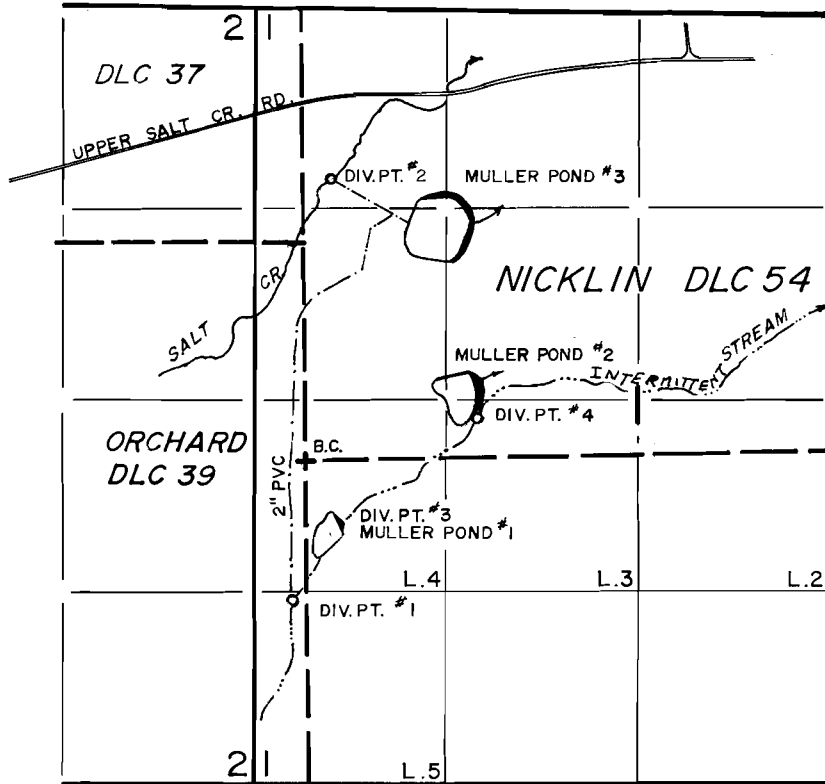

DIV. PTS. LOC.: No. 1; 960'S. & 100'W., No. 2; 1930'N. & 190'E., No. 3; 430'S. & 260'E., No. 4; 270'N. & 1190'E., DAM No. 3; 1690'N. & 1130'E., ALL FROM SW COR. NICKLIN DLC 54.

**FINAL PROOF SURVEY**

UNDER

R-50308 ✓

R-6161

R-51792

R-6167

Application No. 51793... Permit No. 38198.....

IN NAME OF

.....CHRIS MULLER.....

Surveyed MAY 30..... 1979., by R.G. MUCKEN.....