51694

T. 3N. R. 28E. W.M.

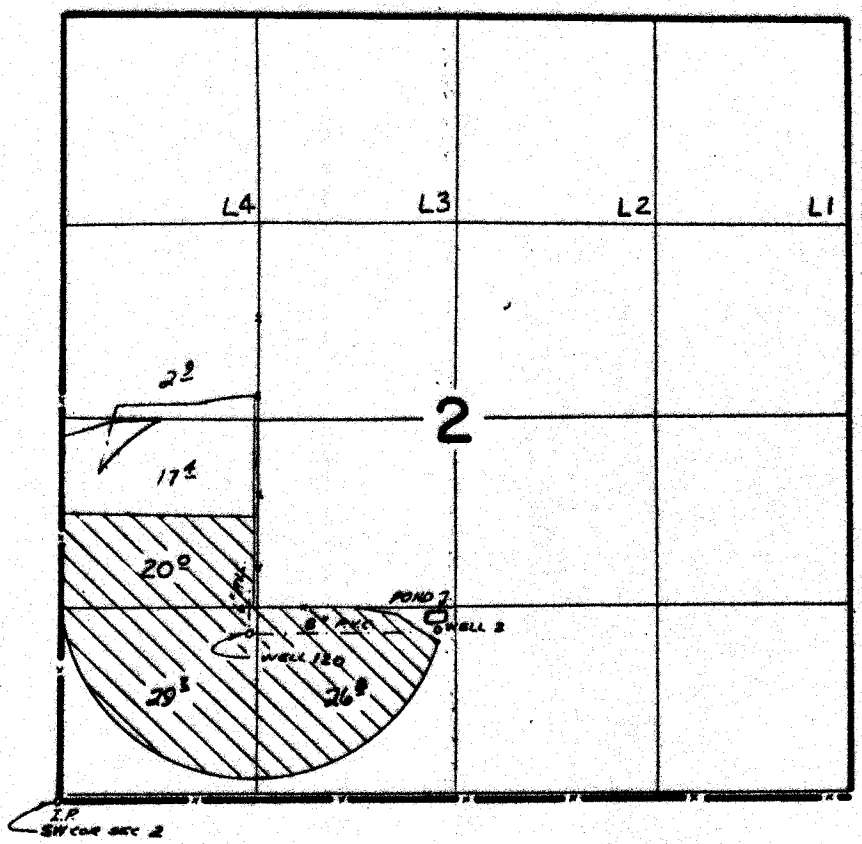

WELL 120 LOCATED 1150' N. & 1300' E. FROM SW COR SEC 2
WELL 2 LOCATED 1170' N. & 2570' E. FROM SW COR SEC 2

FINAL PROOF SURVEY
UNDER

Application No. G 7493 G 6368 Permit No. G 6969 G 5964 WELL 2 WELL 120
IN NAME OF

FRED ANDREWS

Surveyed MAR 15 JULY 13 19 78, by R. BARWIN

PTS-1978-P-A
PTS-1978-P-D