


T. 4N., R. 29E., W.M.

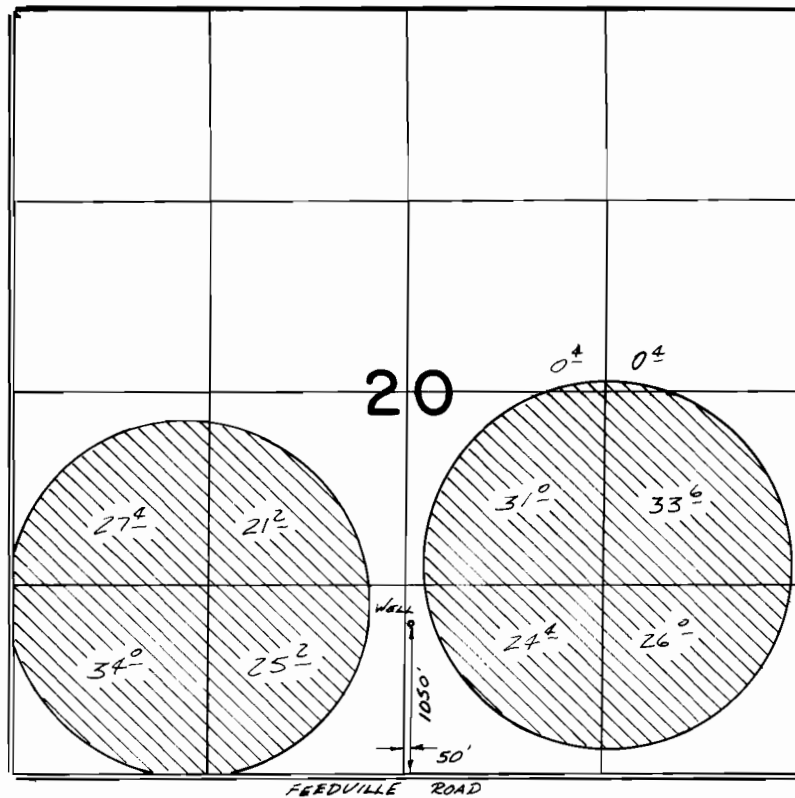

FINAL PROOF SURVEY
UNDER

Application No. **G:7844** Permit No. **G:7182**....
IN NAME OF

..VERNON.. & IVAN..... COOK.....

Surveyed *Aug...7.....* 19*82*., by *V.L. Church*.....