


G-7746
52698

T. 2N., R. 33E., W.M.

SE1/4 NE1/4 SEC. 7

SCALE 1" = 400'

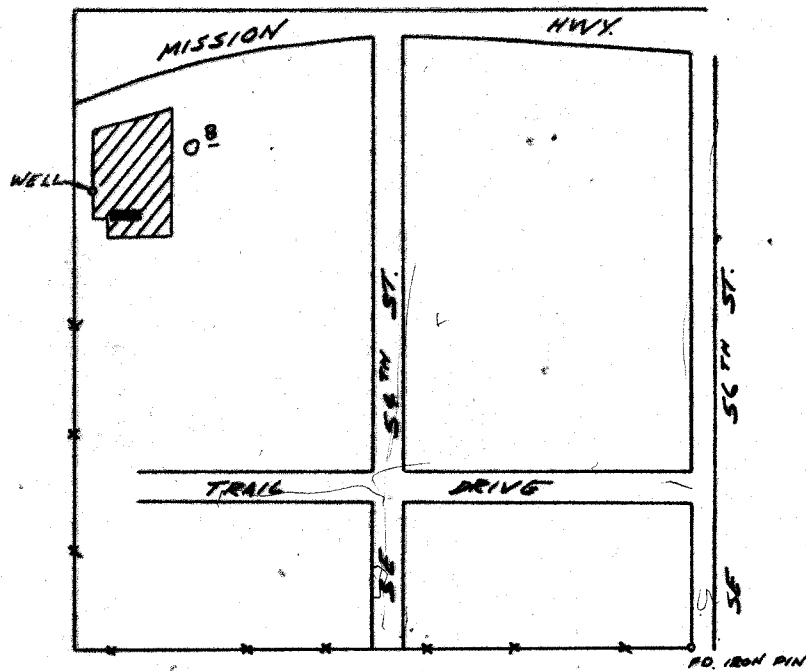

WELL LOCATED 950' N & 1250' W. FROM E 1/4 COR.

SEC 7

FINAL PROOF SURVEY
UNDER

Application No. G-8107 Permit No. G-7746
IN NAME OF

JOHN R. ENGLISH

Surveyed Oct 9 1980, by James Lee Chubb