


T. 1S. R. 38E. W.M.

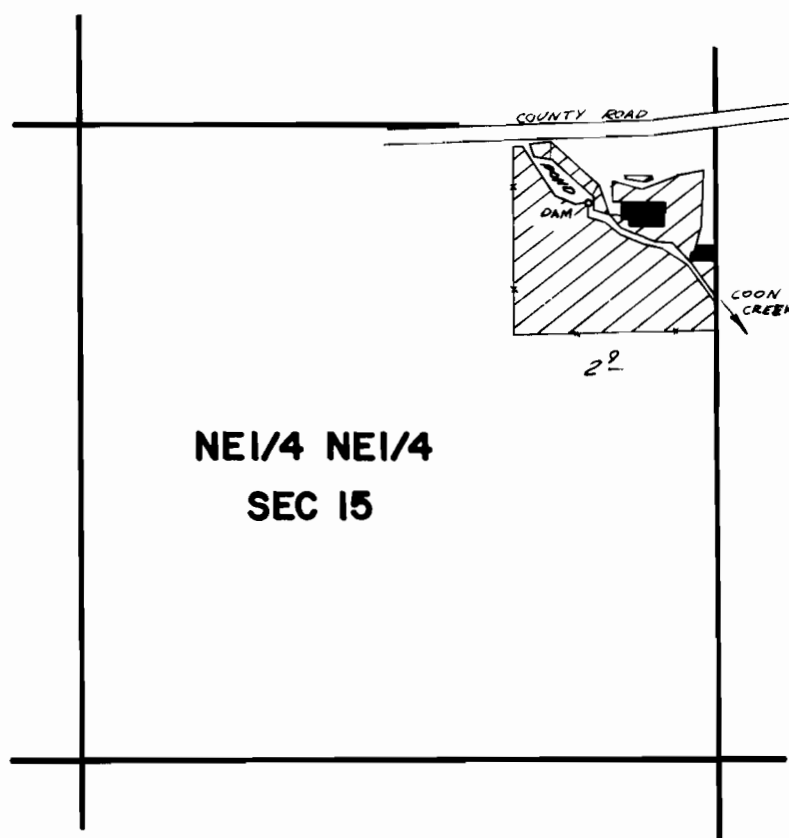

DAM LOC. 165' S. & 260' W. FROM NE COR SEC 15

FINAL PROOF SURVEY
UNDER

Application No. 51918 Permit No. 39062
IN NAME OF

ELTON C. CLEMENS, JR.

Surveyed 6-12 1978, by R. BARWIN