T.1&2S.,R.45E.,W.M.

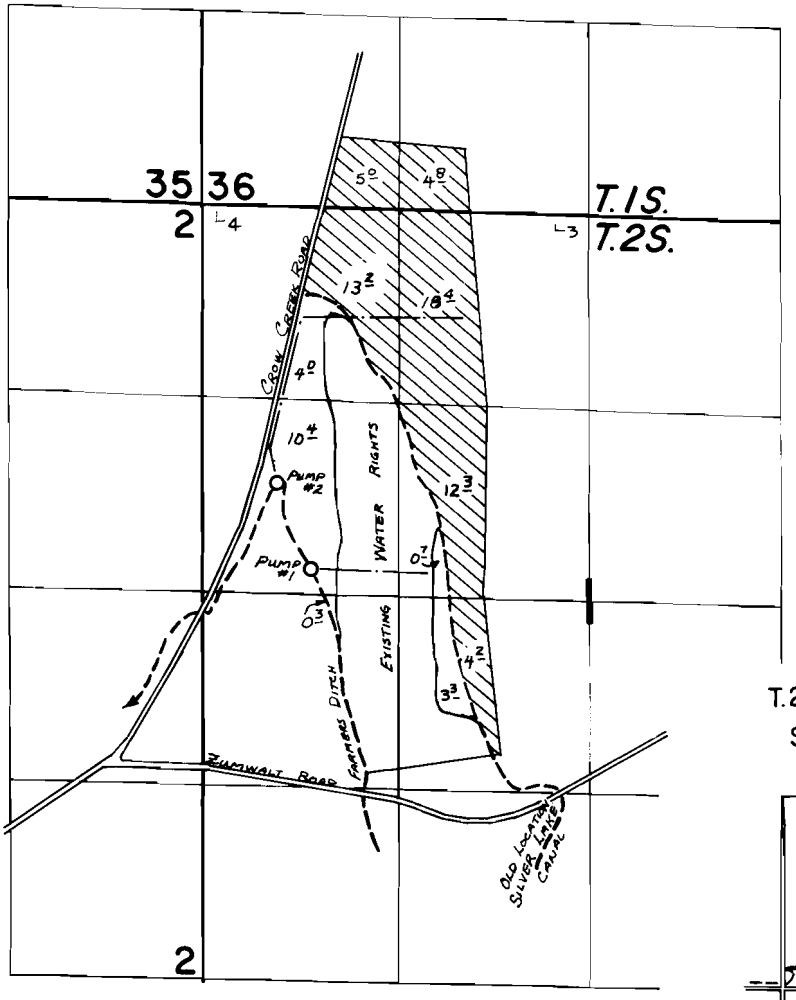

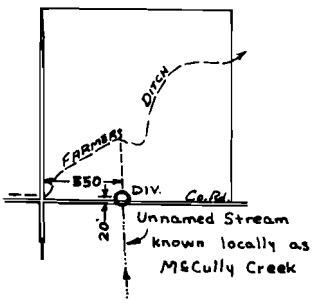

FINAL PROOF SURVEY

UNDER

Application No. 40759 Permit No. 30353

IN NAME OF

GREGORY J. TSIATSOS

Surveyed Aug. 1 1973, by R.G. MUCKEN

BBA-3MM-98
BBA-3MM-102 MT