


T.I.S.R.I.W.W.M.

Application No. R-54240, 54241  
Permit No.

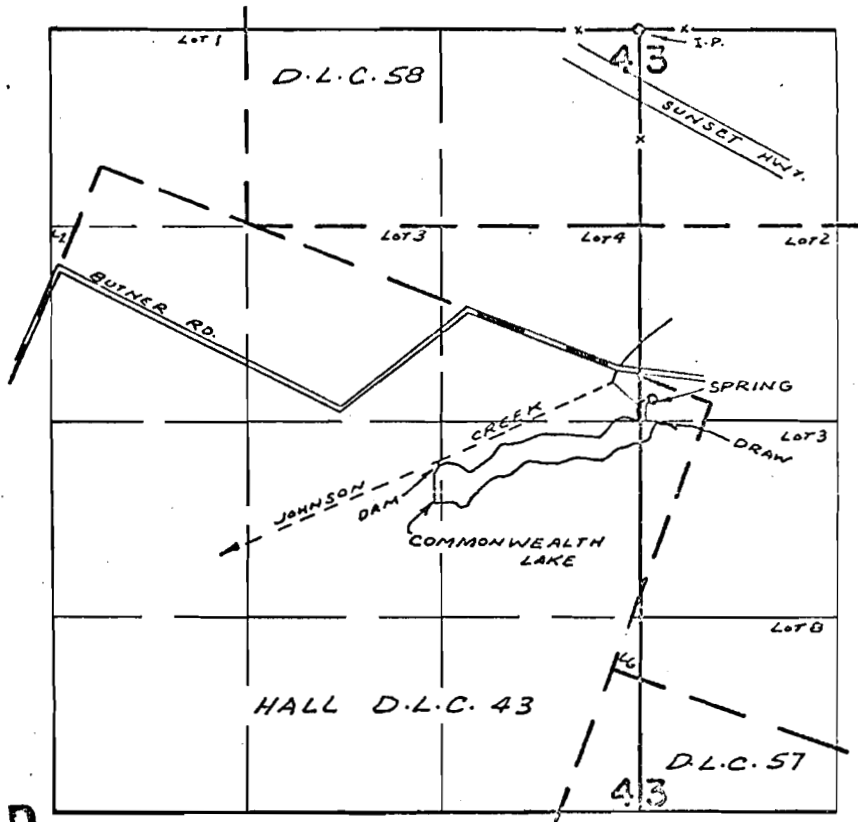

DIV. PT. LOC. 2940'S. & 1360'W. FROM N.E. COR. SEC. 4

RECEIVED

MAY 10 1976

WATER RESOURCES DEPT  
SALEM, OREGON

FINAL PROOF SURVEY  
UNDER

RECEIVED

WATER RESOURCES DEPT  
SALEM, OREGON

R-46488      R-5478  
Application No. 46489      Permit No. 34404  
IN NAME OF

TUALATIN HILLS PARK & RECREATION DISTRICT

Surveyed OCT. 31, 1972, by R. MUCKEN