T.1S.R.1W.W.M.

Application No. R-54240, 54241
Permit No.

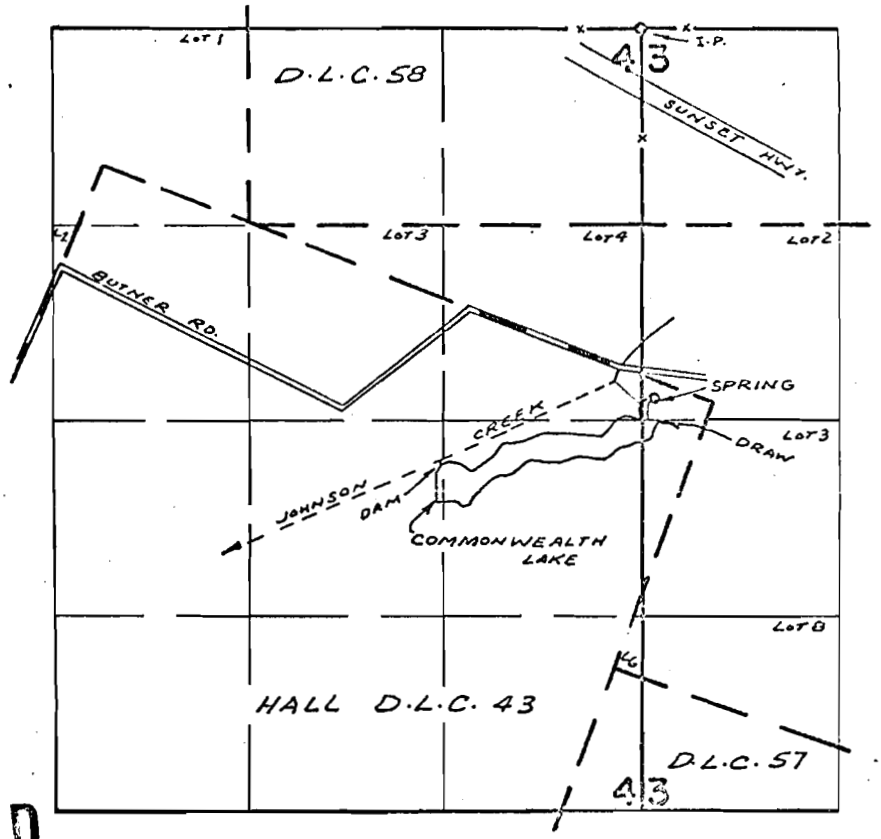

DIV. PT. LOC: 2940'S. & 1360'W. FROM N.E. COR. SEC. 4

RECEIVED
MAY 10 1976
WATER RESOURCES DEPT
SALEM, OREGON

RECEIVED
WATER RESOURCES DEPT
SALEM, OREGON

FINAL PROOF SURVEY
UNDER

Application No. R-46488 46489 Permit No. R-5478 34404
IN NAME OF

TUALATIN HILLS PARK & RECREATION DISTRICT

Surveyed OCT. 31, 1972, by R. MUCKEN

1972-0