


T.3S.R.5W.W.M.

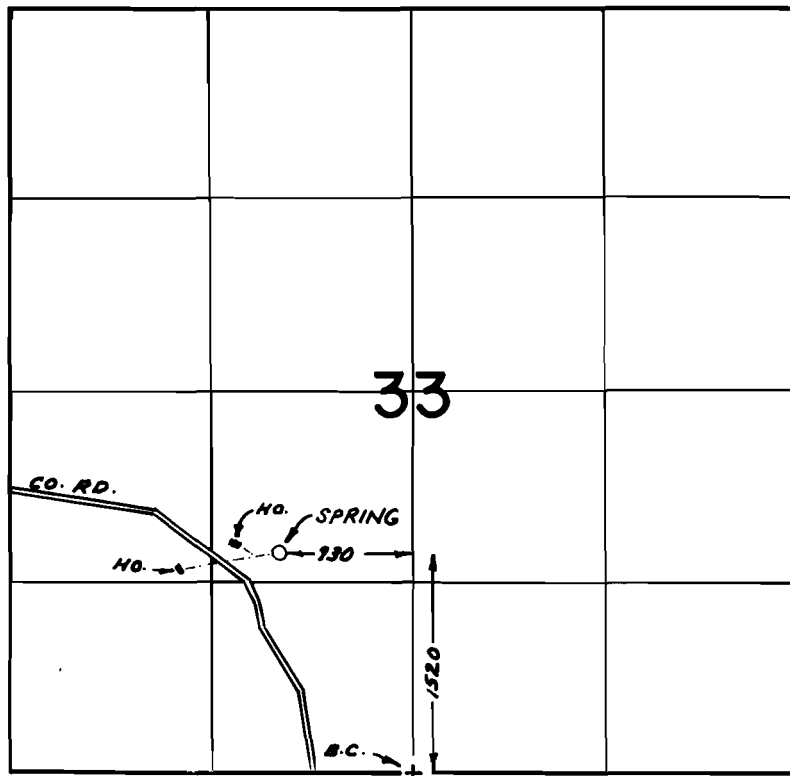

FINAL PROOF SURVEY
UNDER

Application No. 53112.... Permit No. 38592....
IN NAME OF

.....HAROLD G. SMITH.....

Surveyed OCT. 19. 1979, by R. G. MUCKEN