


T.5S.,R.6W.,W.M.

Section 10

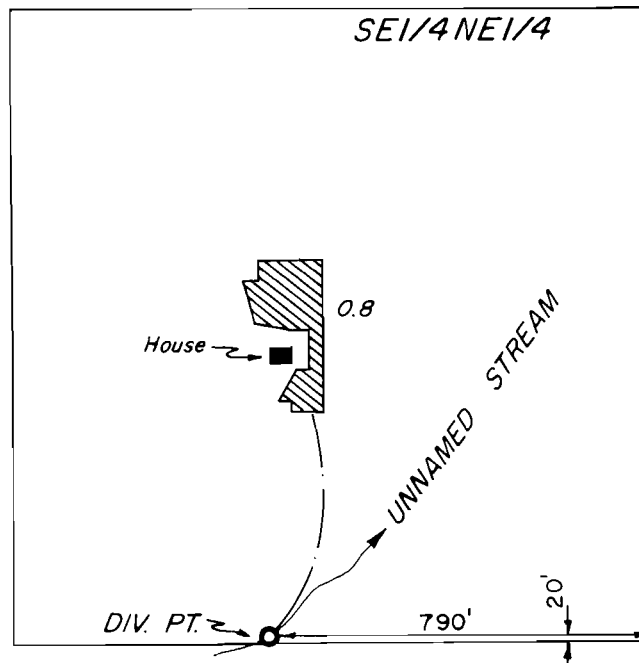

SCALE 1" = 400'

FINAL PROOF SURVEY
UNDER

Application No. 54600. Permit No. 40969.....

IN NAME OF

Wilfred H. Fitzgerald

Surveyed AUG. 21, 1979, by *dlb*.....