


# T. 5 S., R. 3 W., W.M.

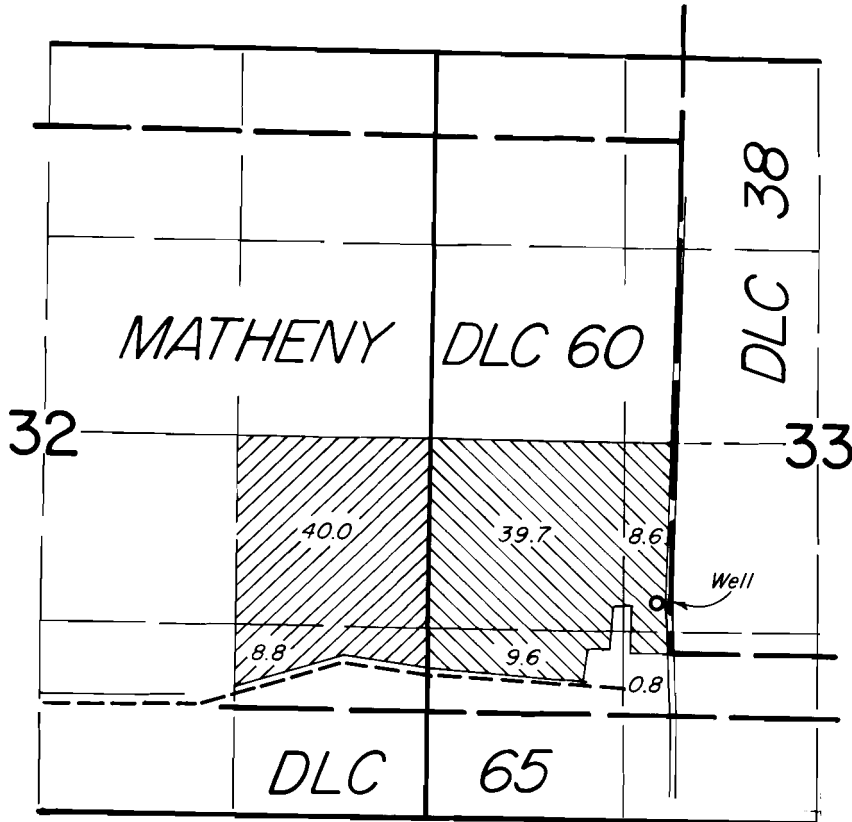

Well Loc.: 300 ft N. & 90 ft W. from the SW Cor. DLC 38

Primary  Supplemental 

## FINAL PROOF SURVEY UNDER

Application No. G-5689 Permit No. G-5503

IN NAME OF

EVERGREEN FARMS

Surveyed JUNE 7, 1980, by [Signature]