


T.13S., R.5W., W.M.

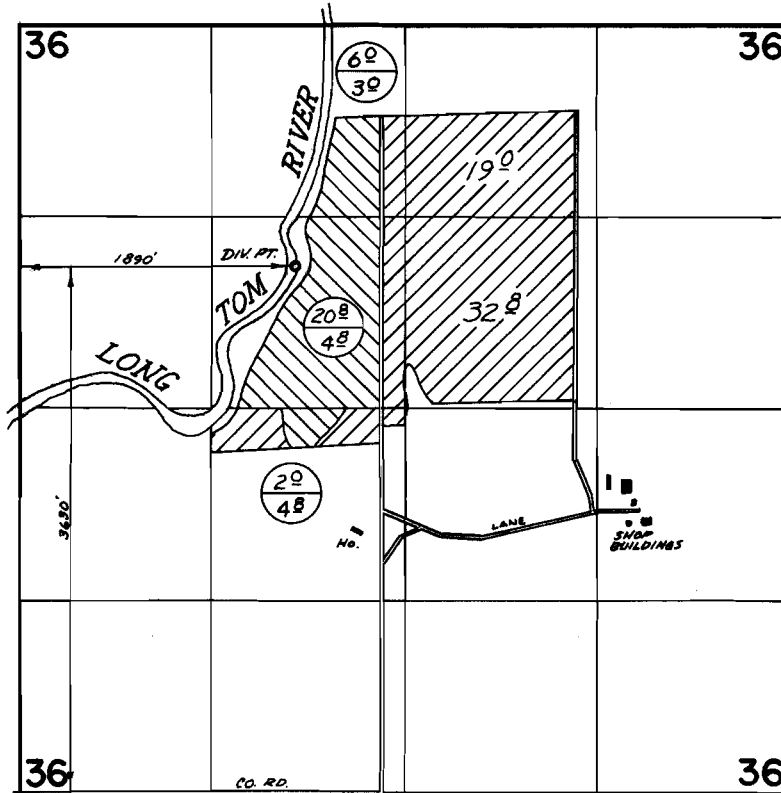

FINAL PROOF SURVEY UNDER

Application No. 10483 Permit No. 36422
IN NAME OF

GEORGE HORNING

Surveyed APRIL 24 1973, by D. Nobby