


T. 5 S. R. 1 E. W. M.

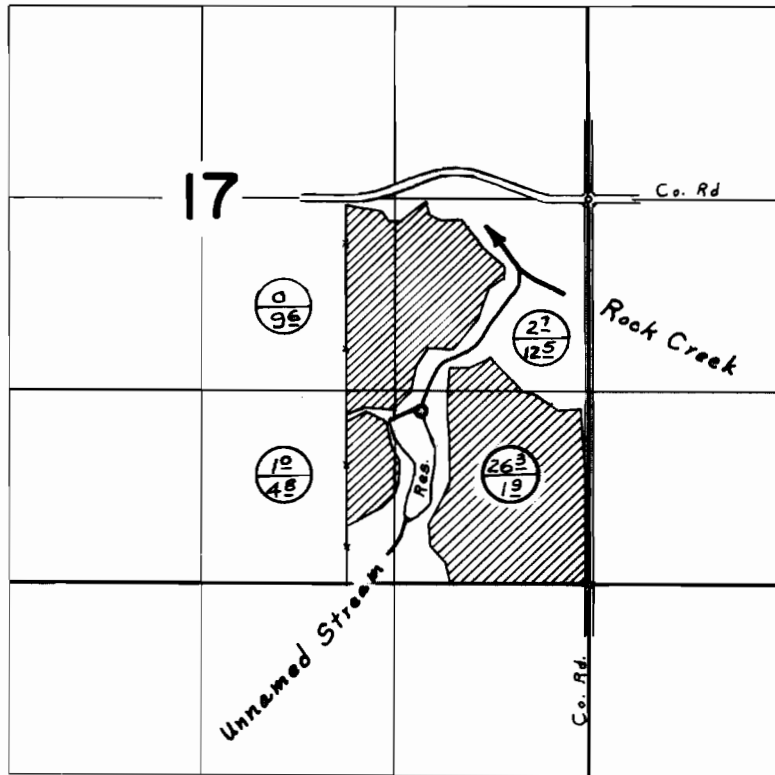

Div. Pt. located 1180' N. & 1140' W. from S.E. Cor. Sec. 17

⊖ ← Permit 25528
⊖ ← Permit 28049

FINAL PROOF SURVEY UNDER

Application No. 37609.. Permit No. 28049..
IN NAME OF

JOHN J. SCHMITZ

Surveyed Oct. 16, 1967., by L. E. Gould..