T. 30S. R. 6W. W.M.

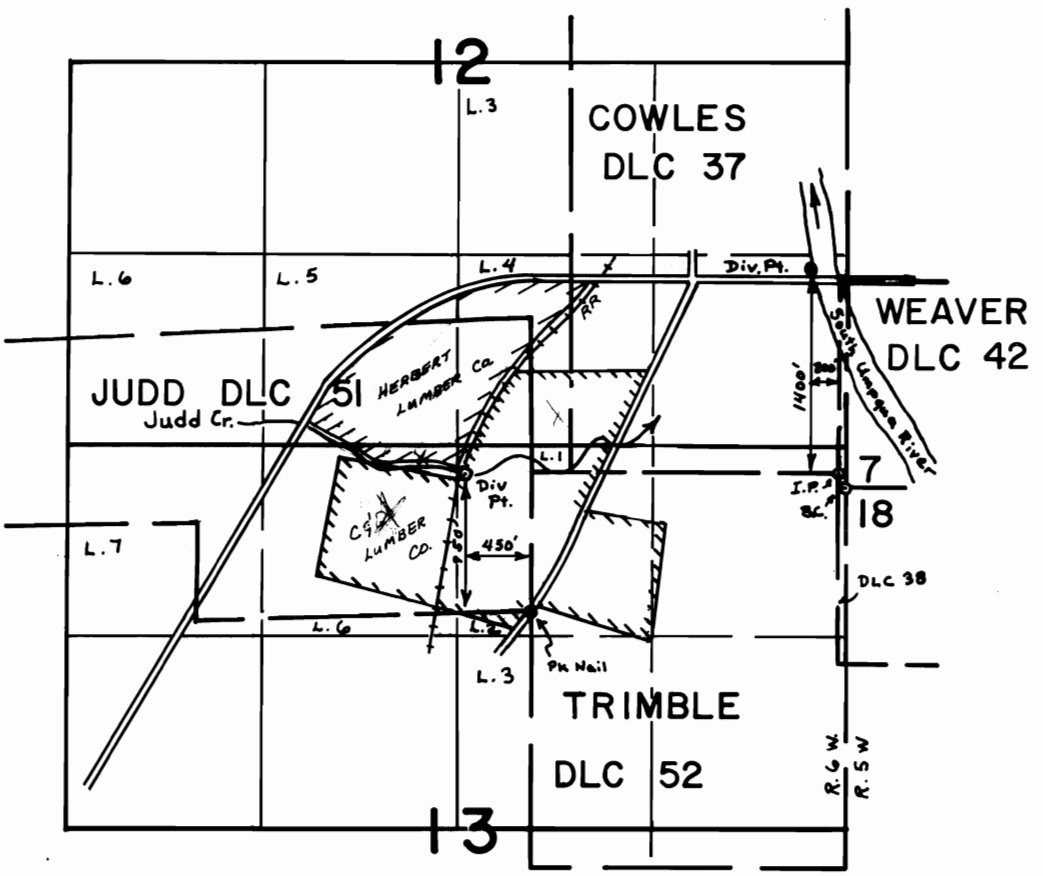

SCALE: 1" = 1320'

FINAL PROOF SURVEY

UNDER

Transfer No. 3557
Transfer No. 3558

Application No. ..... Permit No. .....

IN NAME OF

C&D LUMBER CO.
SO. UMPQUA INVESTMENTS

Surveyed Feb. 10 1978, by D. Sparks
June 23 1980 J. S. DONALDSON

DougCo 76 208-20 & 76 190-5 JSD