P-2658
51727
1396
37365

PARTIAL
CANCELLATION
S.O.V. 33 P. 71
S.O.V. 37 P. 302
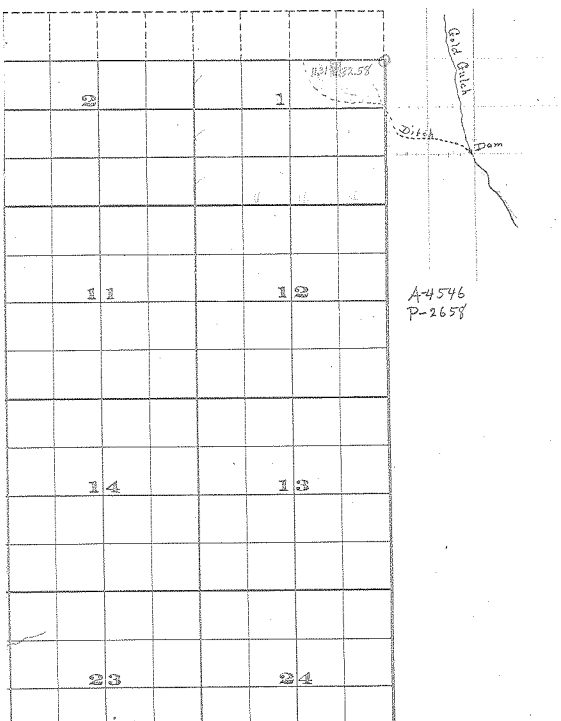
e T. 14 S. R. 31 E.