


T. 4 S. R. I W. W. M.

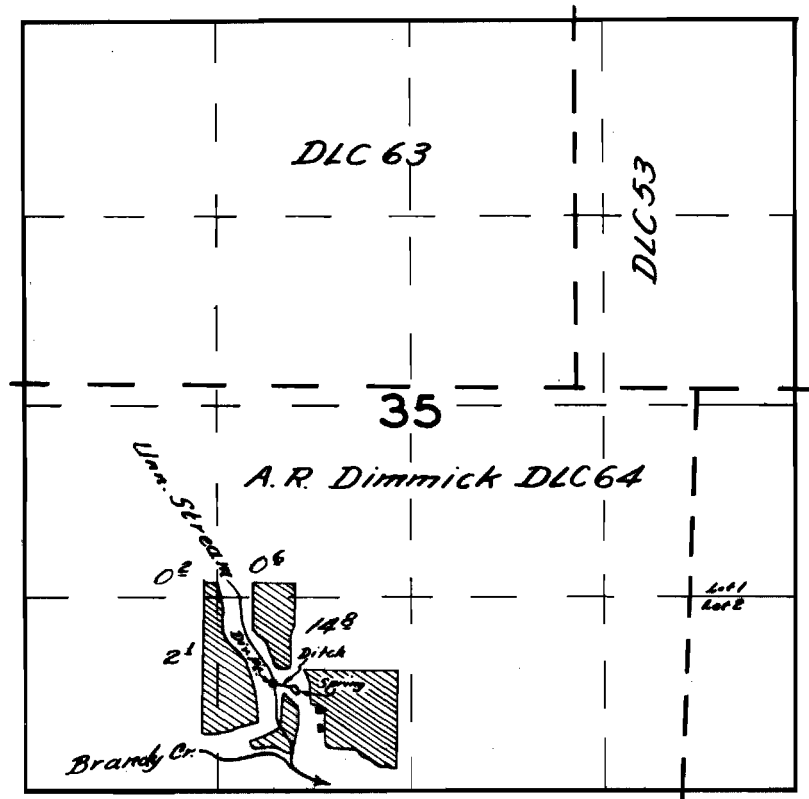

FINAL PROOF SURVEY

UNDER

Application No. 24612 Permit No. 12466
IN NAME OF

M. M. Monnier

Surveyed *Sept. 19, 1956*, by *M. Bisk*.....

DFK-2D-79

C.B.