



T. 4 N. R. 35 E. W. M.

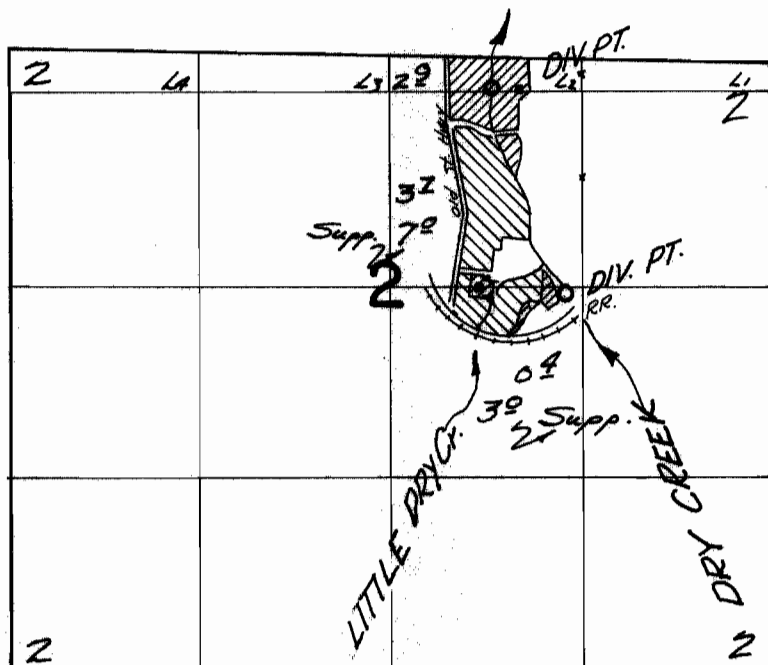

Div. Pts. located 1610 ft. S & 120 ft. W.; 220 ft. S & 620 ft. W. both from the NE cor Lot 2, (NW 1/4 NE 1/4)

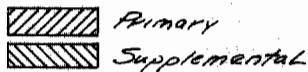

FINAL PROOF SURVEY
UNDER

Application No. 34396 Permit No. 27098
IN NAME OF

JAMES or BLANCH BEAMER

Surveyed Oct. 31, 1966, by V. GARNER