


T.1N. R.14E. W.M.

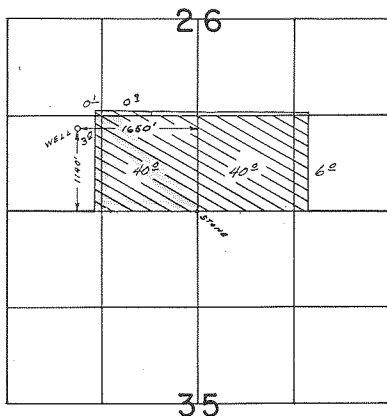

FINAL PROOF SURVEY
UNDER

Application No. G-7133... Permit No. G-6584.
IN NAME OF

.....GEORGE HARTH.....

Surveyed SEP...15... 1977, by L.H. NUNN.....