


P 26849
SUP 42568
51743
55044

T.6S.R.21E.W.M.

see also
P 26848

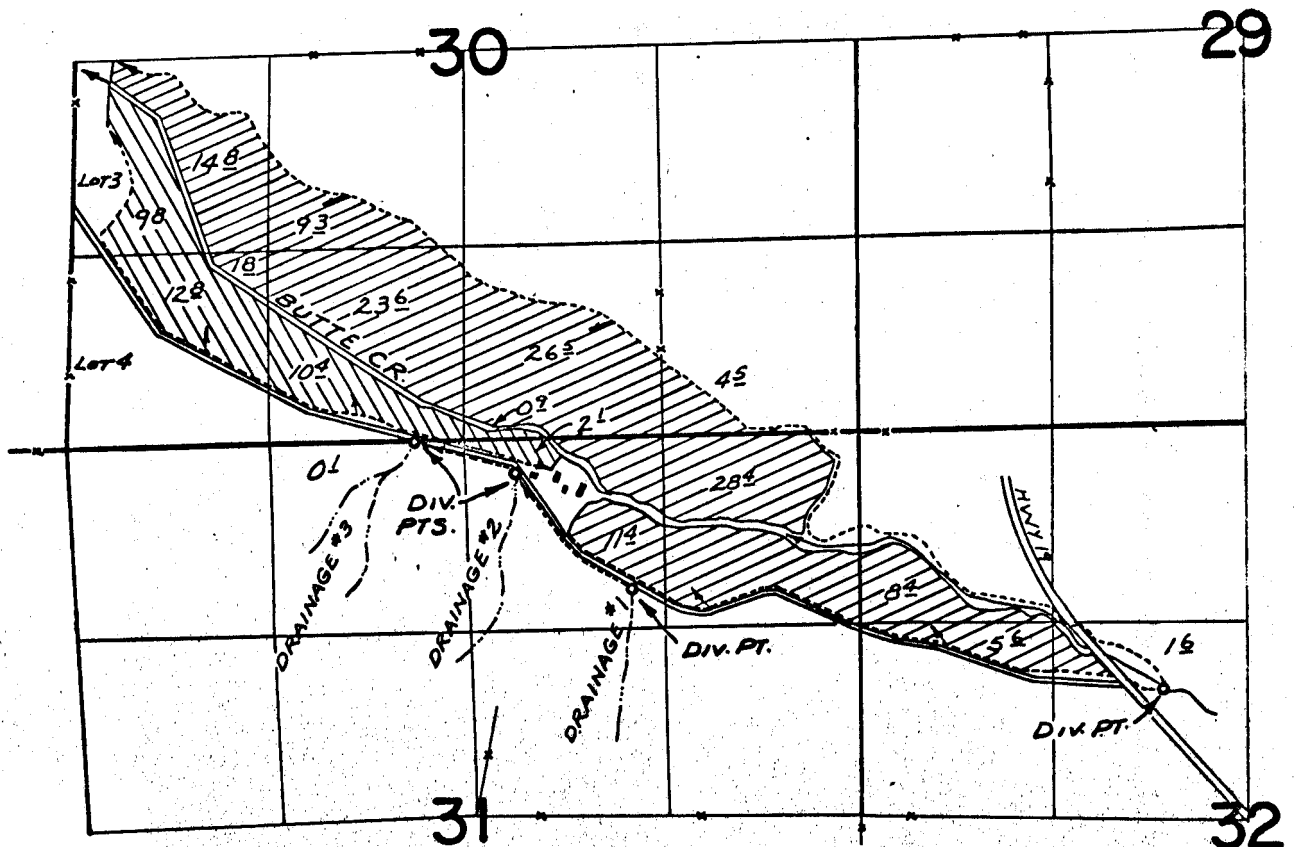

DIV. PTS. LOC: BUTTE CR. - 1800'S. & 2070'E.; UNN. DRAIN #1 - 1050'S. & 1550'W; #2 - 240'S. & 2350'W; #3 - 10'S. & 3030'W, ALL FROM N.E. COR. SEC. 31

 LAND IRRIGATED FROM BUTTE CR. ONLY

 LAND FOUND IRRIGATED FROM BUTTE CR. & 3 DRAINAGES

FINAL PROOF SURVEY UNDER

Application No. ³⁴⁰⁵⁶~~34057~~ Permit No. ²⁶⁸⁴⁸~~26849~~
IN NAME OF

MORRIS E. & VIOLA M. WILSON

Surveyed JULY 10, 1968, by K. GARNER