


T.2&3S.R.4W.W.M.

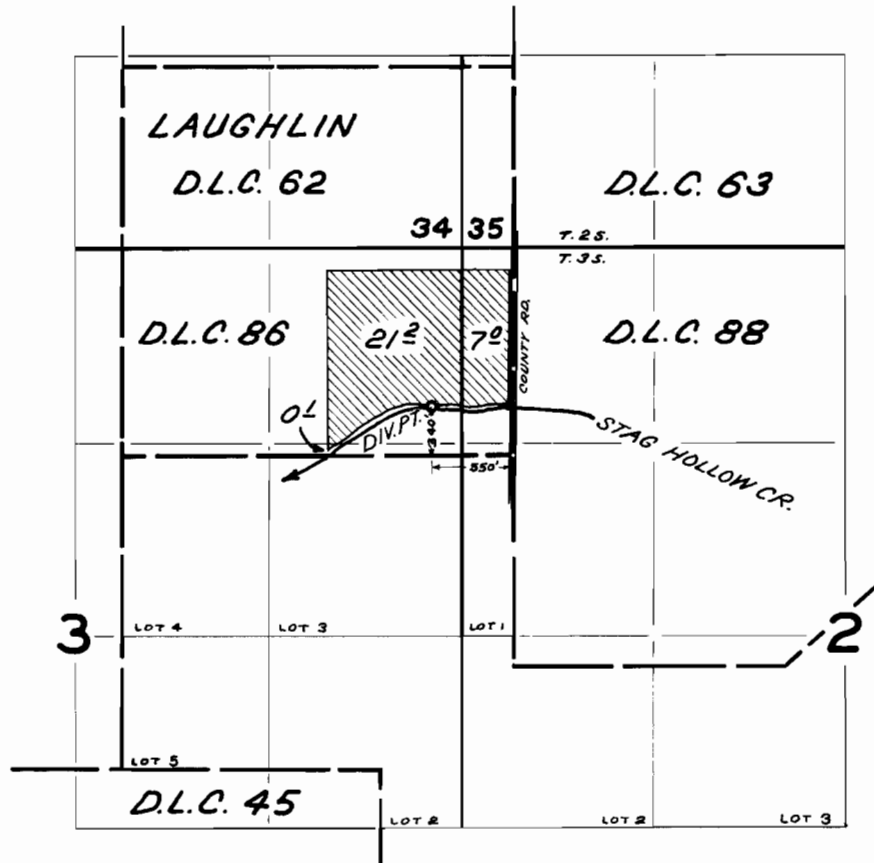

FINAL PROOF SURVEY
UNDER

Application No. 42216 Permit No. 31574
IN NAME OF

HAROLD E. GEELAN

Surveyed APR 5 1967, by V. GARNER