


T. 9S. R. 40E. W.M.

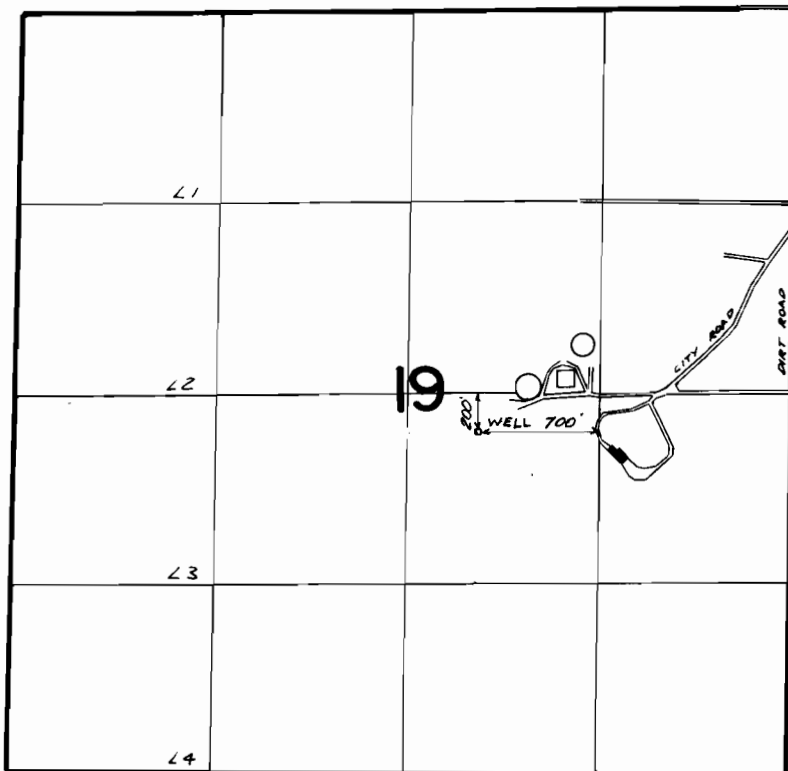

FINAL PROOF SURVEY
UNDER

Application No. G-8381 Permit No. G-7635
IN NAME OF

THE CITY OF BAKER

Surveyed 5-26 1978, by R. BARWIN