


T3S. R1E. WM.

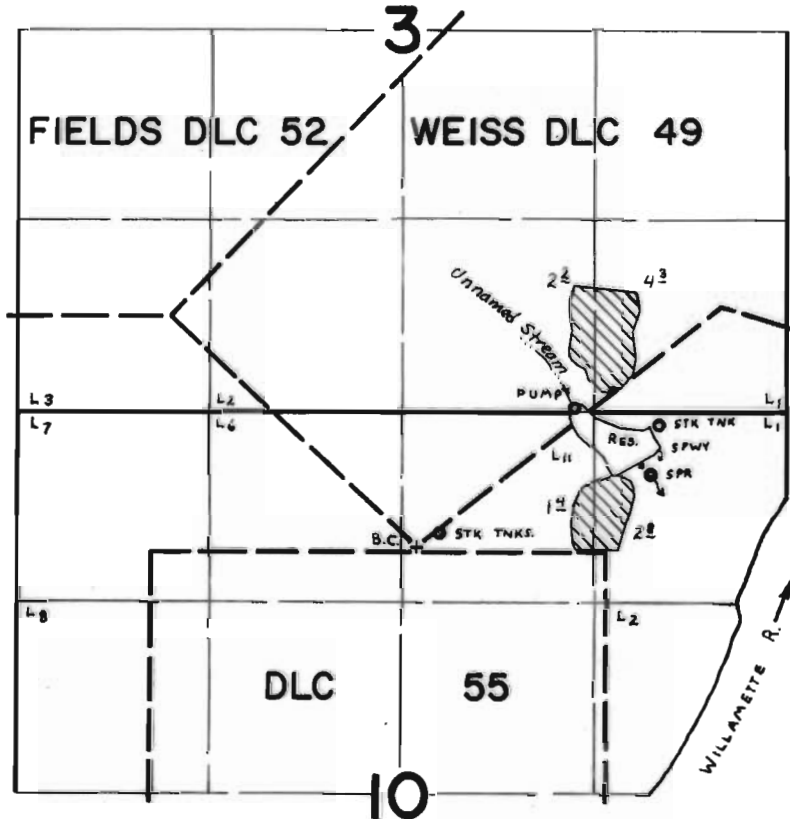

SPRING: 500' N. 159° E } BOTH FROM MOST SOUTHERLY
 DAM: 620' N. 151° E } COR. WEISS DLC 49

FINAL PROOF SURVEY UNDER

R-49572 R-5967
 49392 36781
 47838 35120

Application No. R-47837 Permit No. R-5631
 IN NAME OF

DONALD E. HERSHISER

Surveyed SEPT. 26, 1978, by C. L. HUGHES