


T.28S. R.12W. W.M.

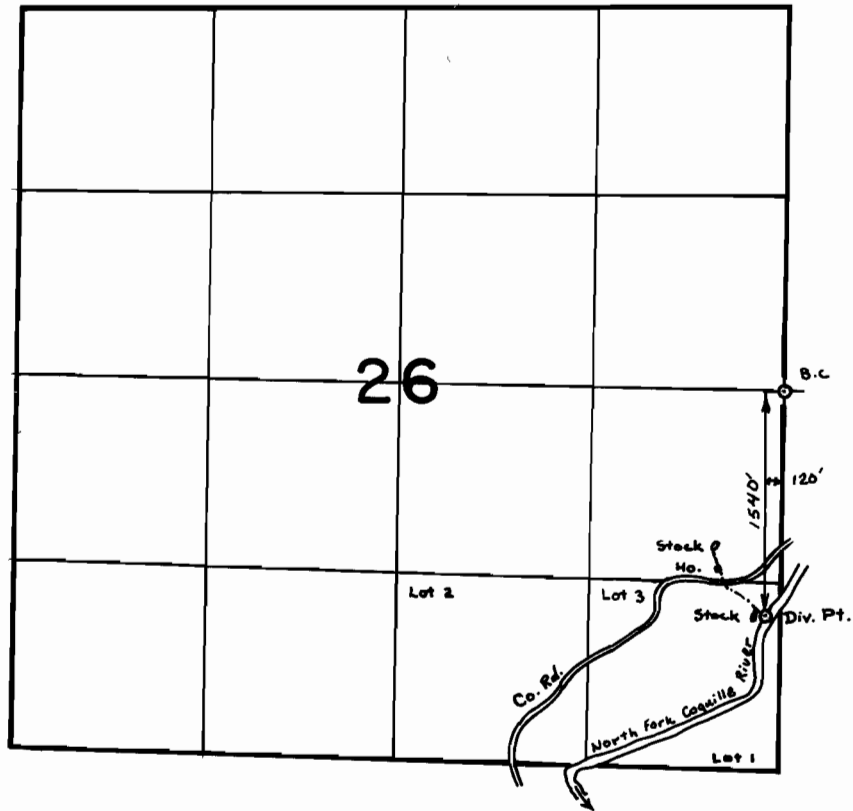

SCALE: 4" = 1mi.

FINAL PROOF SURVEY
UNDER

Application No. 51341 Permit No. 38758
IN NAME OF

GARY E. & SANDRA L. DAVIS

Surveyed May 17 1978, by D. Sparks