


T.30S. R.5W. W.M.

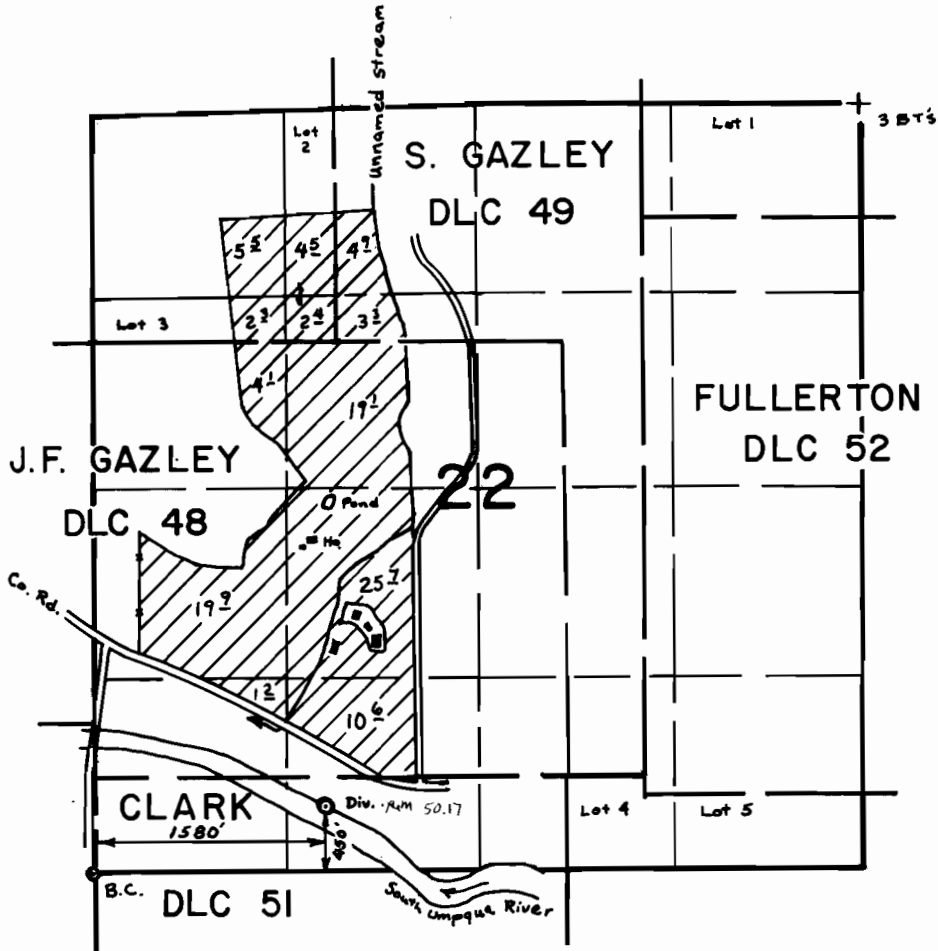

SCALE: 1"=1320'

FINAL PROOF SURVEY
UNDER

Application No. 50229 Permit No. 37917
IN NAME OF

DONALD W. LILJA

Surveyed Feb. 3 1978, by D. Sparks