


T.32 & 33S. R.6W. W.M.

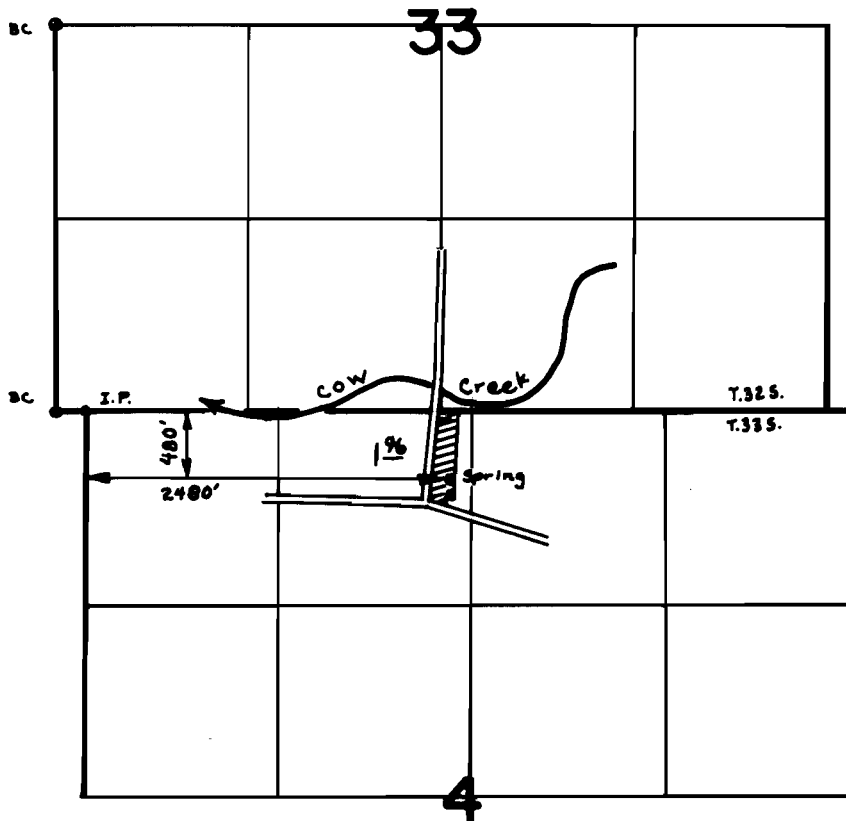

SCALE: 4" = 1 mile

**FINAL PROOF SURVEY**  
UNDER

Application No. 51168..... Permit No. 38671.....  
IN NAME OF

RONALD A. & LINDA C. BRANDT

Surveyed Jan.22., 1978., by S. Donaldson...