


T. 29S. R. 8W. W.M.

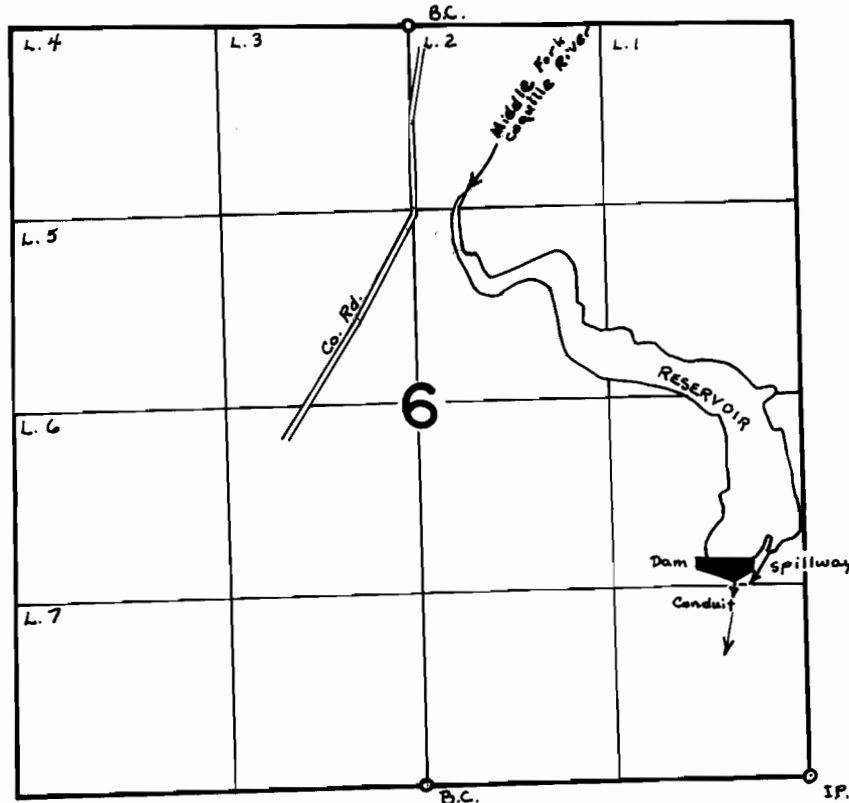

Dam Located 1400' N & 500' W from SE cor. Sec. 6

FINAL PROOF SURVEY
UNDER

R-41732 R-4739
Application No. 42878 Permit No. 31265
IN NAME OF

FRANK R. KINNAN

Surveyed OCT. 31 1978, by S. DONALDSON