


T.27S.,R.17E.,W.M.

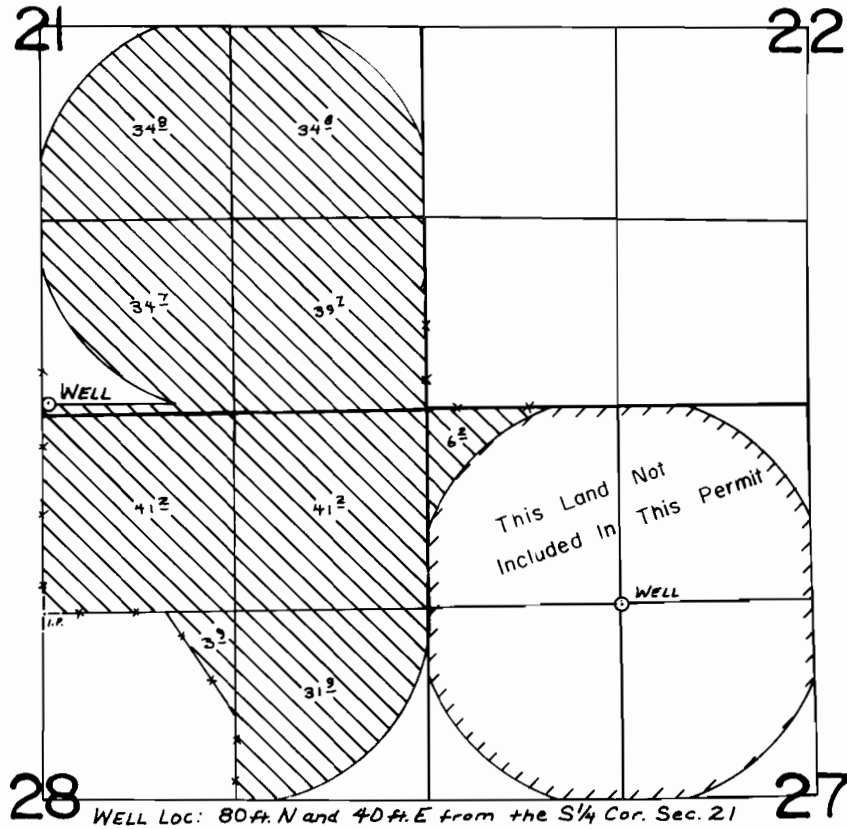

FINAL PROOF SURVEY
UNDER

Application No. G-9831 Permit No. G-8888.....
IN NAME OF

MARVIN G. NAGELY

Surveyed OCT. 29, 1981, by L. TOLL.....