


T.16S.,R.7W.,W.M.

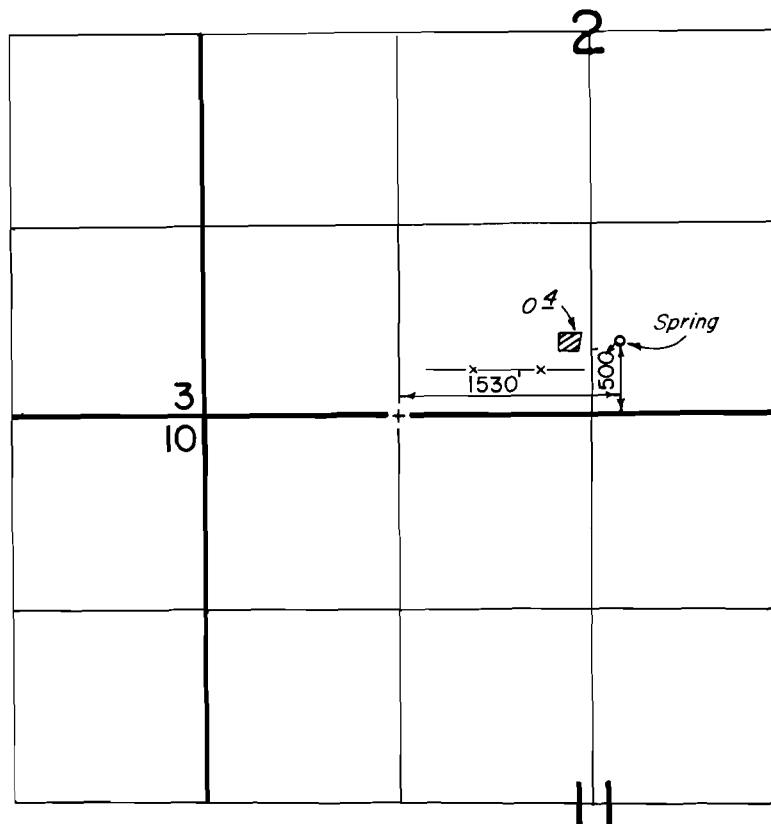

FINAL PROOF SURVEY
UNDER

Application No. 55759 Permit No. 41755
IN NAME OF

WALLACE & GLORIA DERBY

Surveyed MAY 16, 1980, by *[Signature]*