


T.15S.R.6W.W.M.

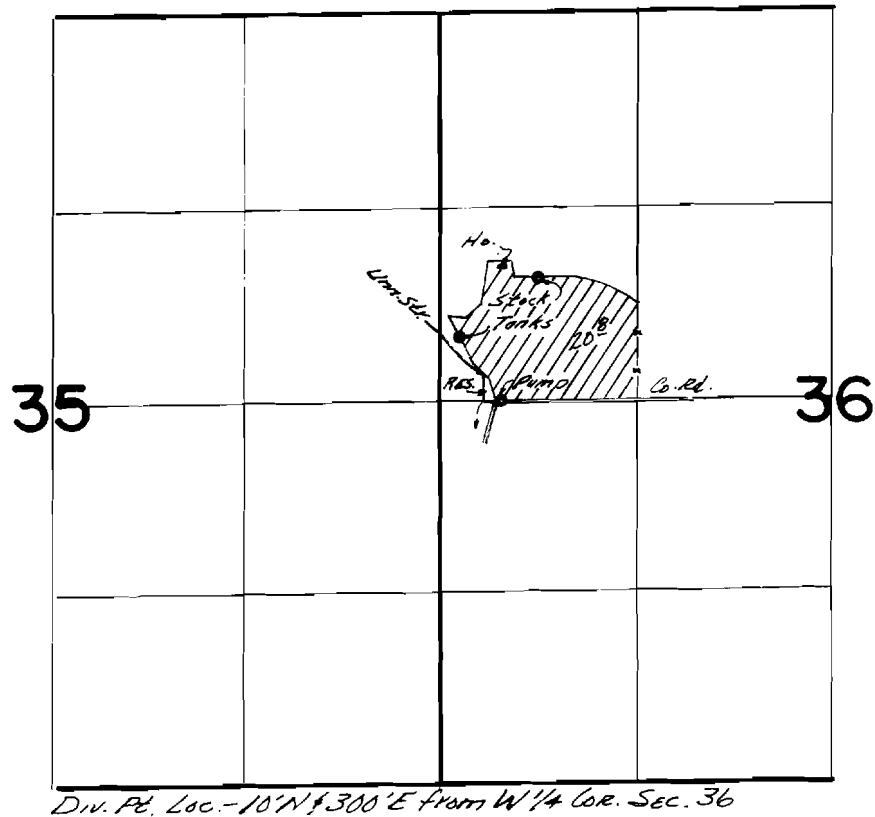

FINAL PROOF SURVEY
UNDER

R-54094 R-6484
Application No. 54095. Permit No. 4068J.....
IN NAME OF

HERMAN CONRAD HILDEBRAND.....

Surveyed Oct...12... 1979., by C.R. RODRIGUEZ....

PTS-1979-CR ? DBQ-BN-71