


T.15S.R.6W.W.M.

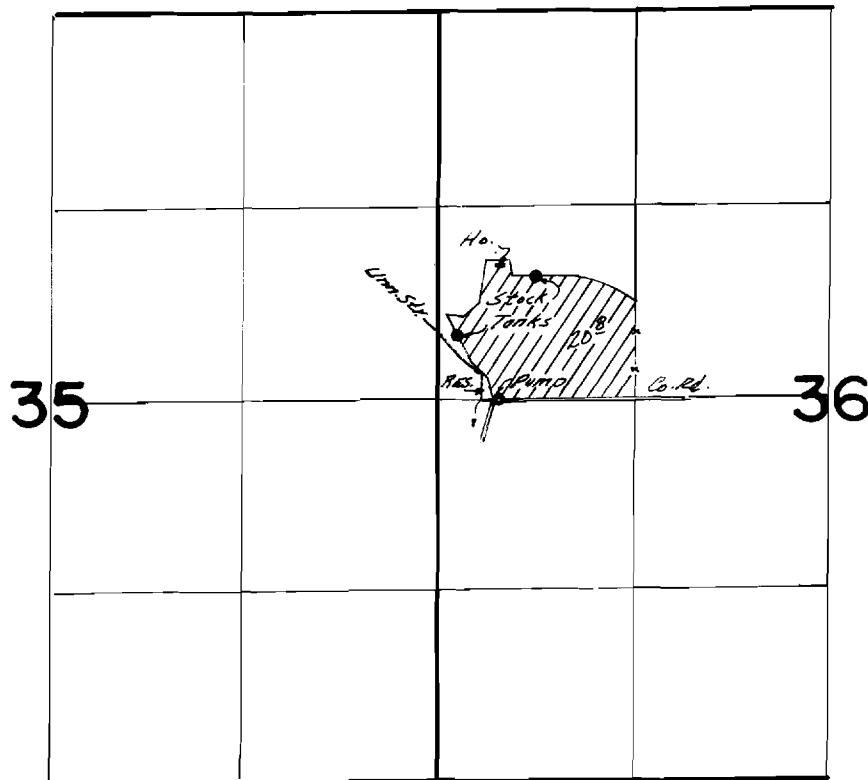

Div. Pt. Loc. - 10' N & 300' E from W 1/4 Cor. Sec. 36

FINAL PROOF SURVEY
UNDER

R-54094 R-6484
Application No. 54095. Permit No. 40681.....
IN NAME OF

HERMAN CONRAD HILDEBRAND.....

Surveyed Oct., 12, 1979., by C. RODRIGUEZ...

PTS-1979-CR & DBQ-84-71