


T. 15S. R. 1W. W. M.

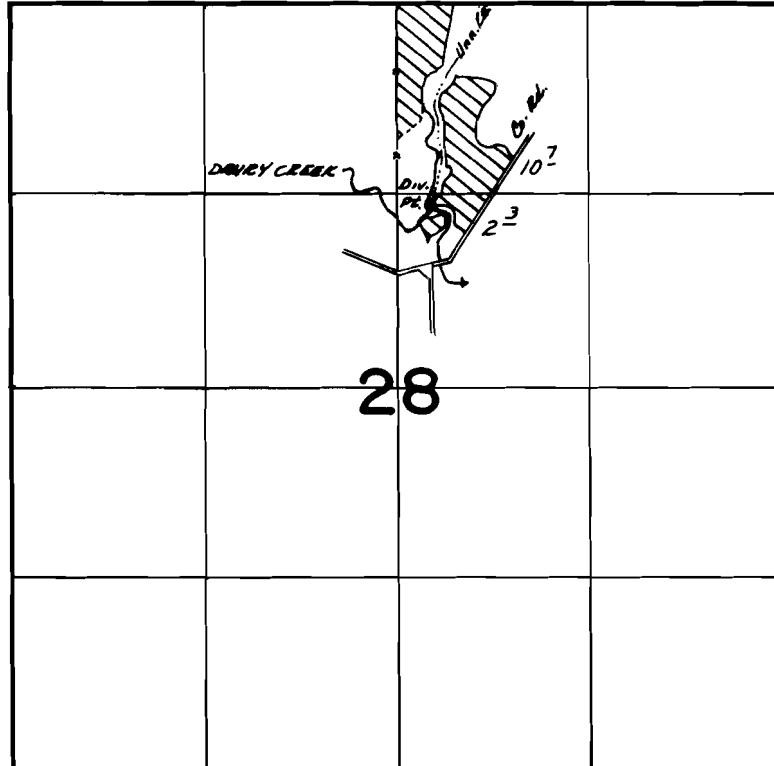

Div. Pt. Loc. 1400'S & 230'E From N 1/4 Cor. Sec. 28

FINAL PROOF SURVEY
UNDER

Application No. 56254. Permit No. 42512.....
IN NAME OF

CLARENCE HORN & JOHN REYNOLDS

Surveyed May...16.. 1979, by S.C.BROWN.....