


T.13S.,R.1E.,W.M.

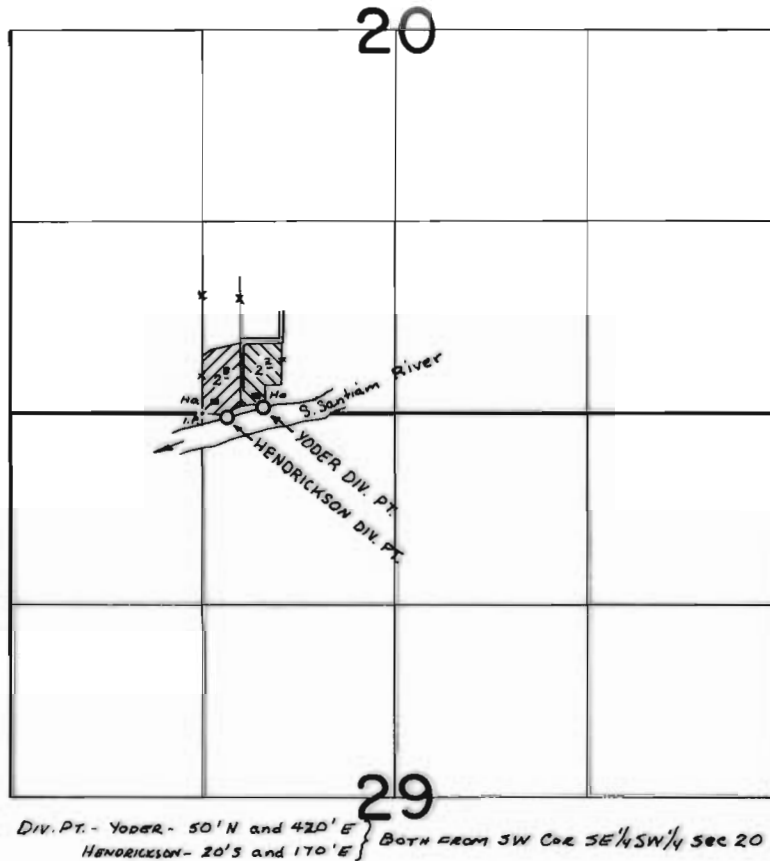

FINAL PROOF SURVEY
UNDER

Application No. 50867... Permit No. 38406.....

IN NAME OF

MAX & IRIS YODER
EARL & DARLENE HENDRICKSON

Surveyed April 26, 1982, by L.M. TOLL.....