


Needs for Irrigation  
 BBC-8N-80  
 T.16 S. R.43 E. W.M.  
 G-5633 -  
 10-5039  
 AE

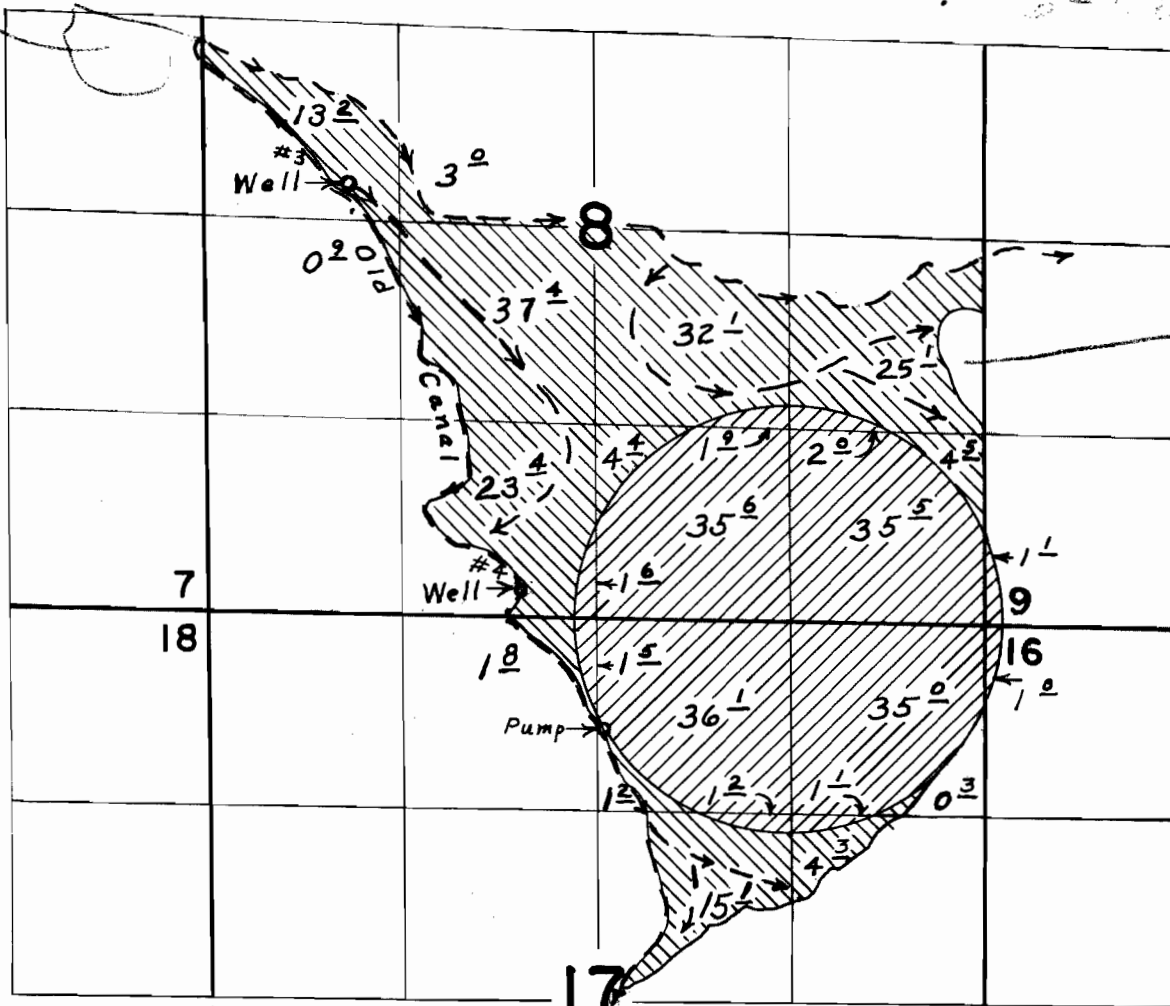

Wells located: #3, 2930' N. & 980' E.; #4, 150' N. & 2180' E.;  
 both from S. W. Cor. Sec. 8

Flooding   
 Sprinkling 

**FINAL PROOF SURVEY**  
 UNDER

Application No. G-3224 Permit No. G-3167  
 IN NAME OF  
 GUM CREEK FARMS INC. and  
 KANSAS CITY LIFE INS. CO.

Surveyed April 26, 1975, by L. E. Gould