


T16S. R43E. WM.

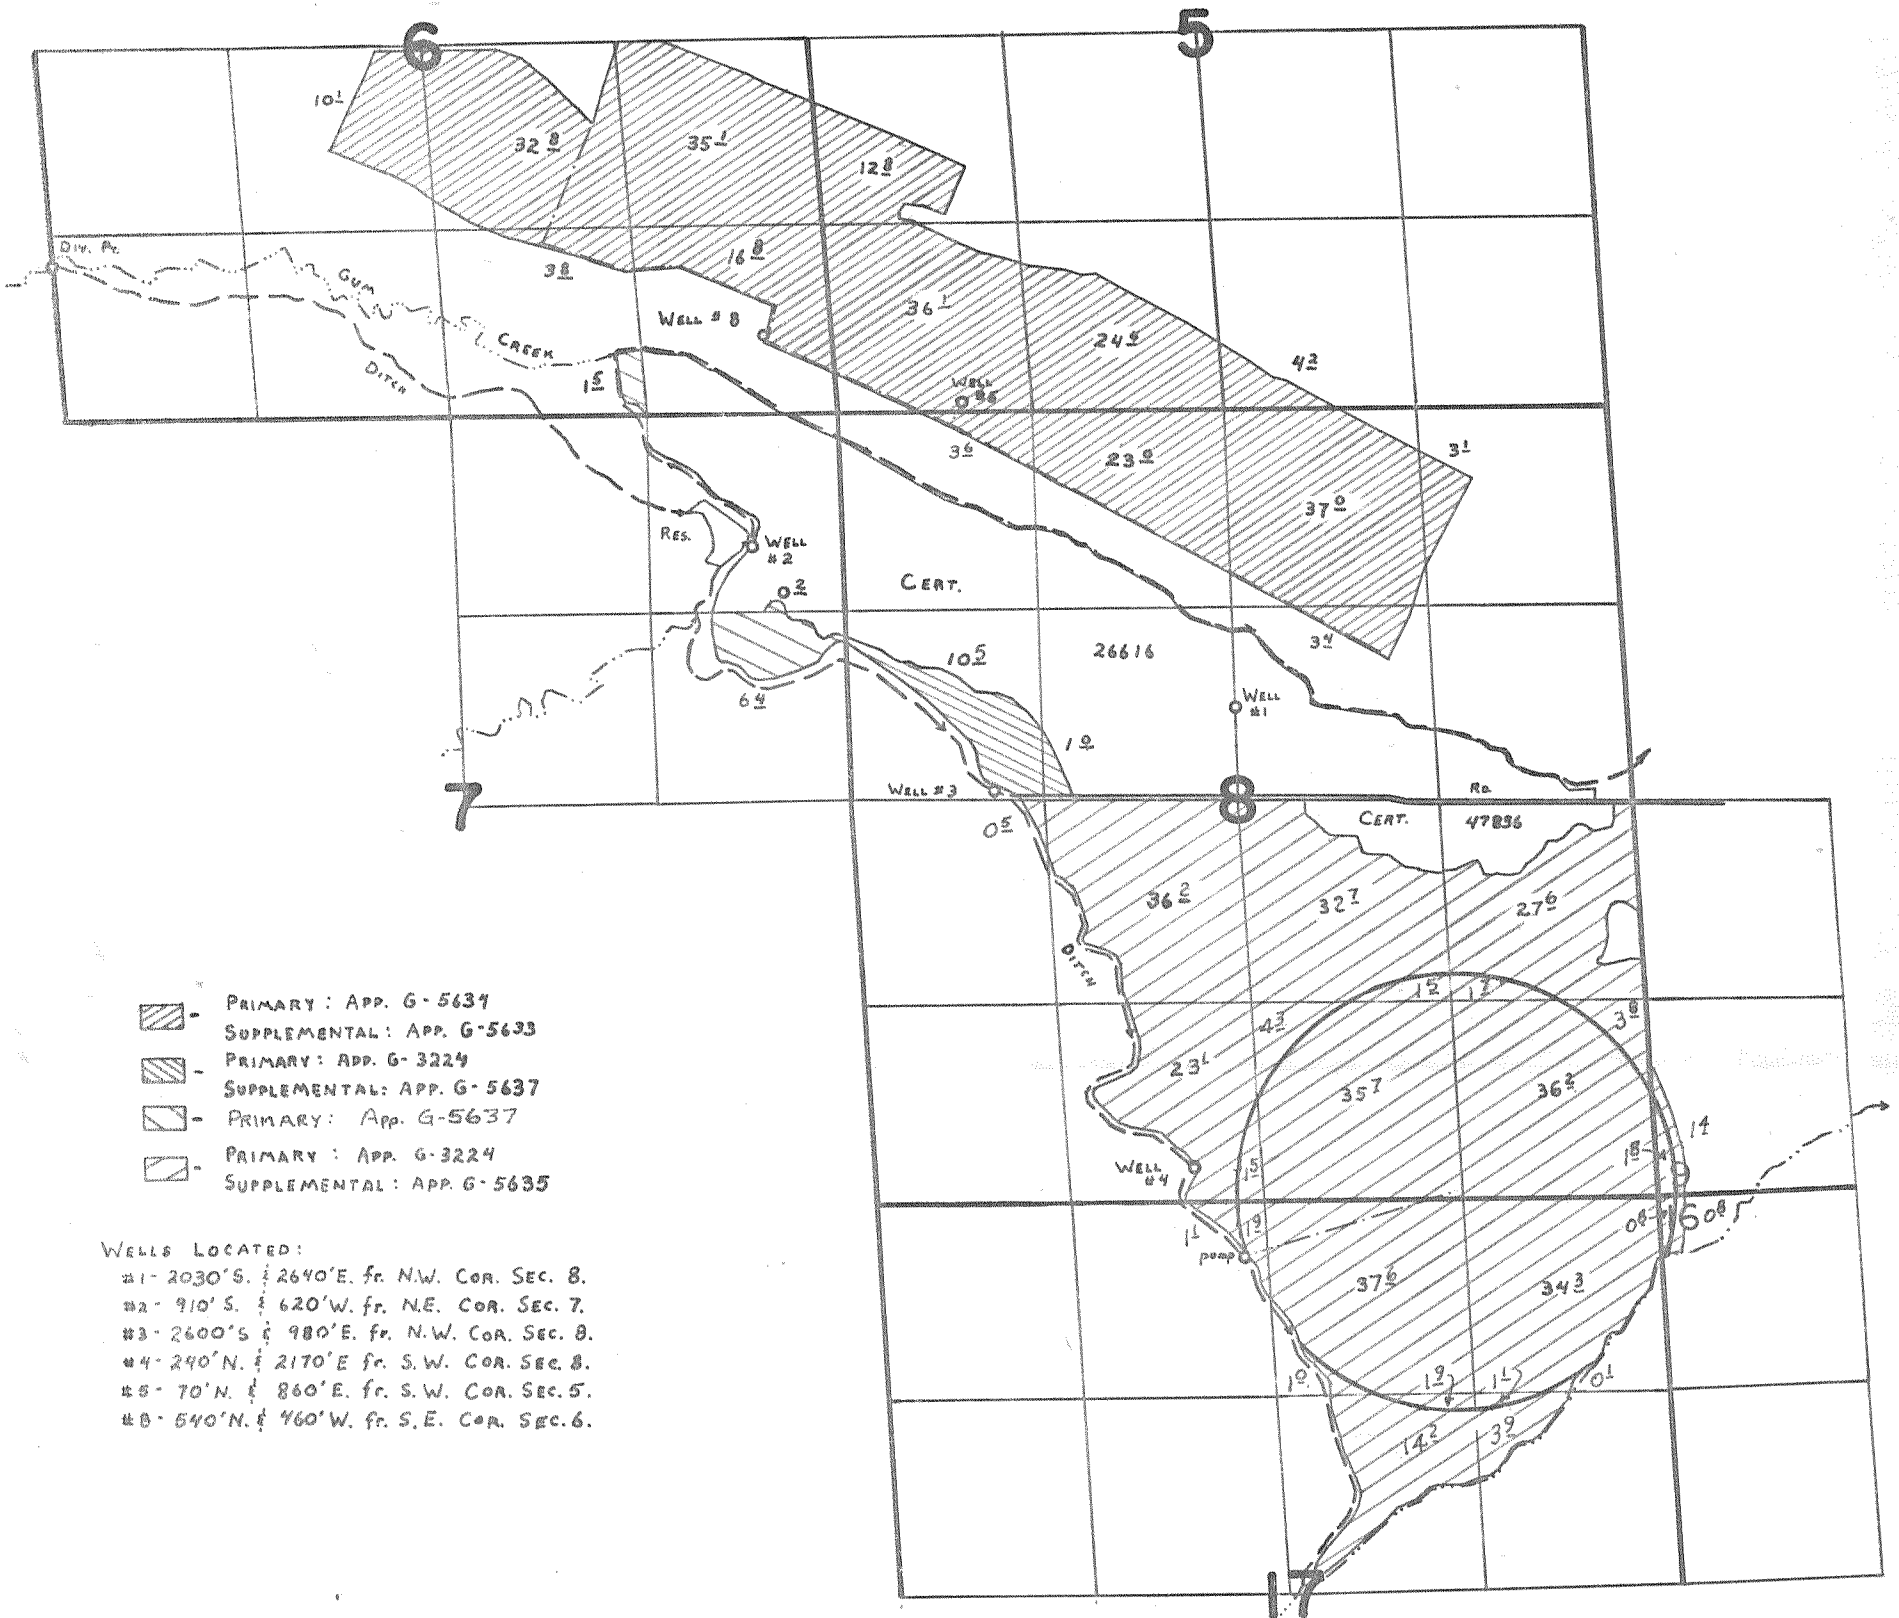

FINAL PROOF SURVEY UNDER

G-5633	G-6719
G-5634	G-6720
G-5635	G-6721
Application Nos. G-5637	Permit Nos. G-6723
G-3224	G-3167

IN NAME OF

**GUM CREEK FARMS, INC. &
KANSAS CITY LIFE INS CO**

Surveyed AUG. 6 1979, by C. L. HUGHES
SEPT 20