G-8619
51782
51781

T. 4N., R. 25E., W.M.

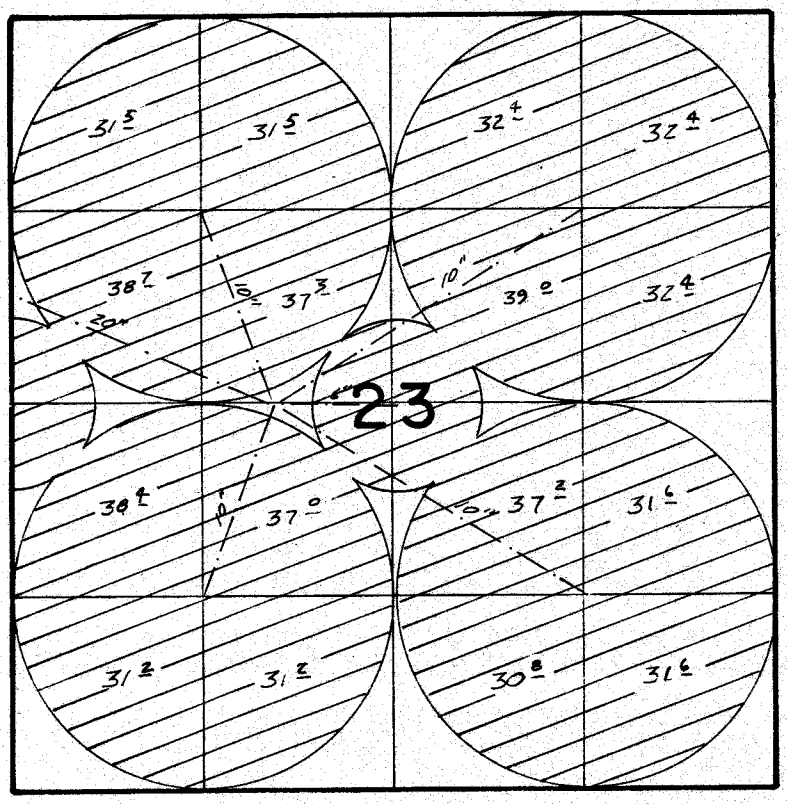

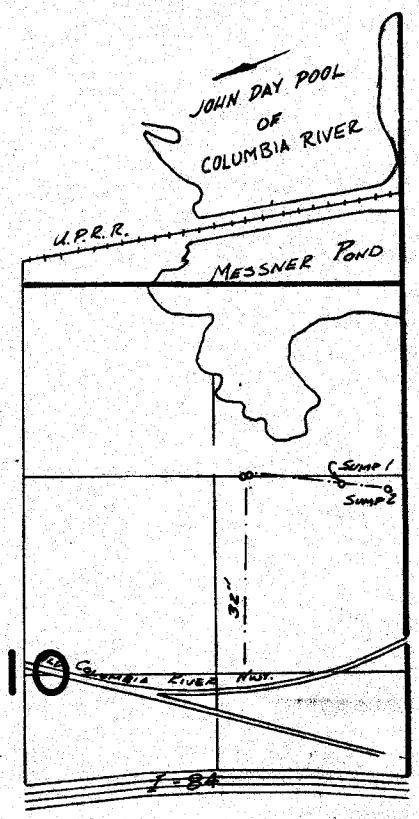

SUMP 1 LOC: 1300'N & 440'W. FROM E 1/4 COR. SEC. 10
SUMP 2 LOC: 1250'N. & 100'W. FROM E 1/4 COR. SEC. 10

FINAL PROOF SURVEY

UNDER

Application No. G-9263 60950 Permit No. G-8619 45468

IN NAME OF

CONN. LIFE GEN. LIFE INS. CO. & MERLE CARLSON

Surveyed May 2 1983, by V.L. Church

231R
PTS-1983-PA2 TIE 272-218 5-3-83