


T. 1N. R. 38E. W.M.

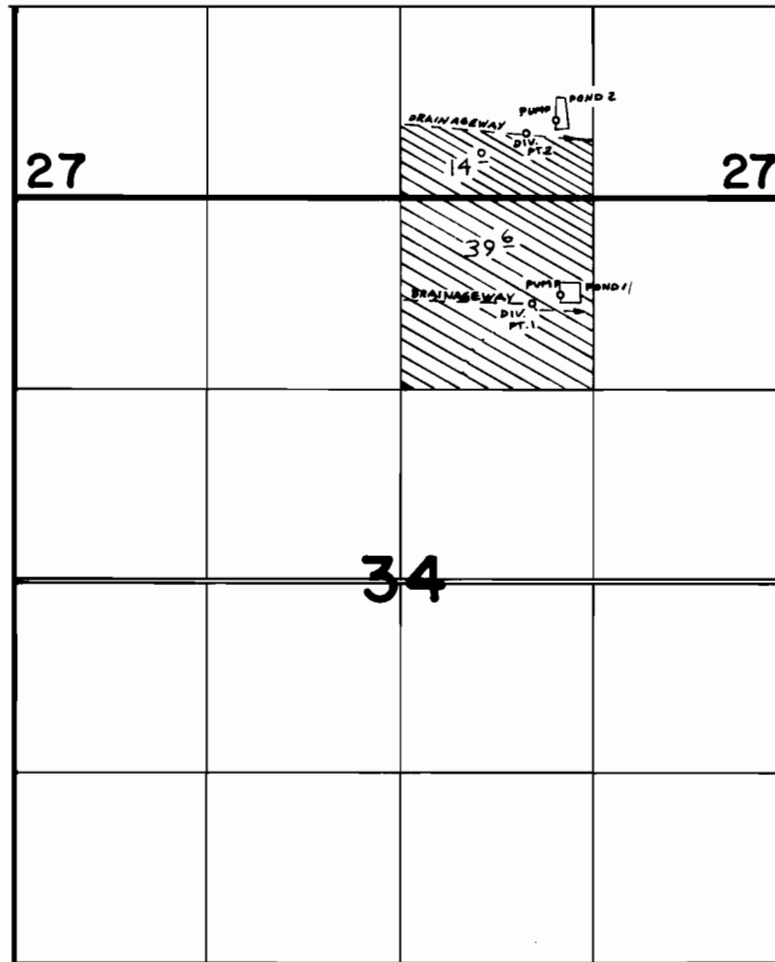

DIV. PT. 2 LOC. 450' N & 860' E FROM S 1/4 SEC 27
DIV. PT. 1 LOC. 730' S. & 900' E FROM N 1/4 SEC 34

FINAL PROOF SURVEY
UNDER

R-48675 R-5838
Application No. 48676 Permit No. 36077
IN NAME OF

JOE W. JARVIS

Surveyed 6-27-1978 by R. BARWIN