


T. 1S. R. 38E. W. M.

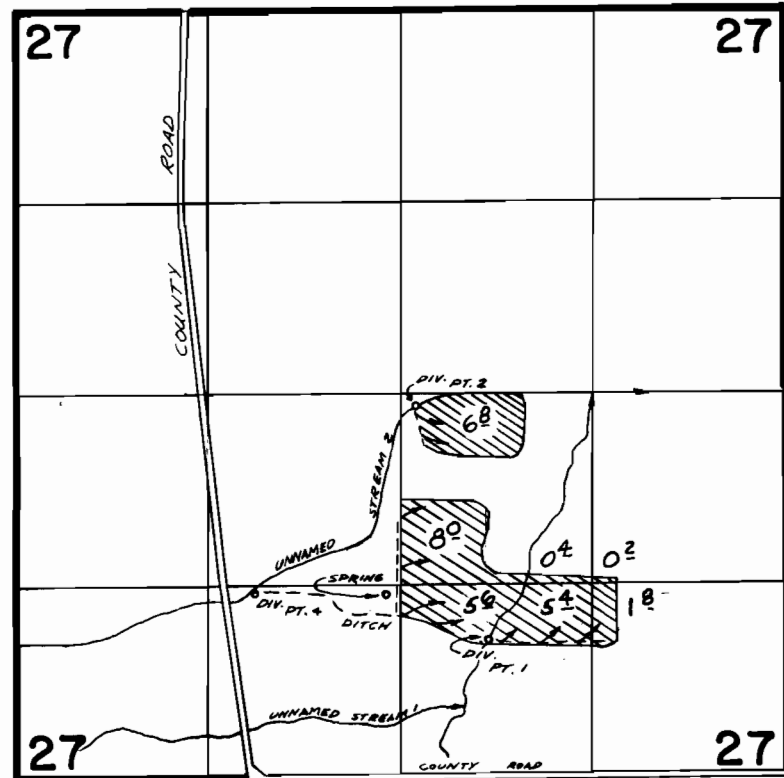

DIV. PT. 1 LOC. 940' N & 600' E. FROM S $\frac{1}{4}$ SEC. 27
DIV. PT. 2 LOC. 70'S & 100' E. FROM CENTER SEC. 27
DIV. PT. 4 LOC. 1260' N & 1650' E FROM SW. COR SEC. 27

FINAL PROOF SURVEY
UNDER

Application No. **52696** Permit No. **39828**
IN NAME OF

RUTH BAY

Surveyed **6-14** 1978, by **R. BARWIN**