


T. 1N. R. 38E. W. M.

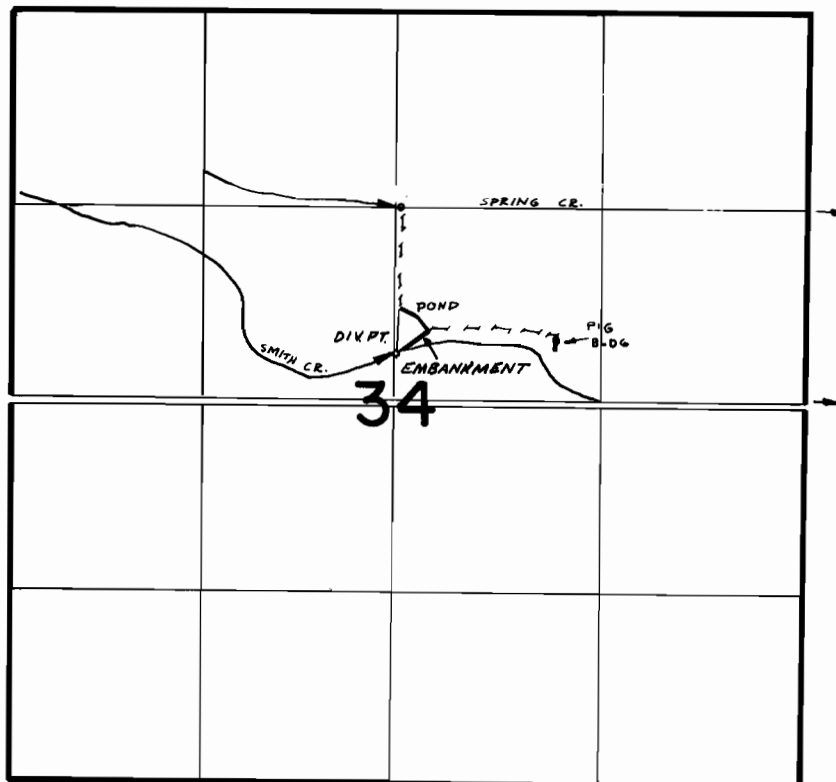

SMITH CREEK DIV PT LOCATED 2350'S. & 20'E FROM N. 1/4 COR SEC 34

FINAL PROOF SURVEY
UNDER

54303 40587
Application No. R-54201 Permit No. R-6473
IN NAME OF

GRANT I. & HELEN D. HENDERSON

Surveyed 6-27 1978, by R. BARWIN