


T.1S. R.2W., W.M.

ALREADY DLG IN SEC. 31
COPY LOOKUP & PUDS No. 0

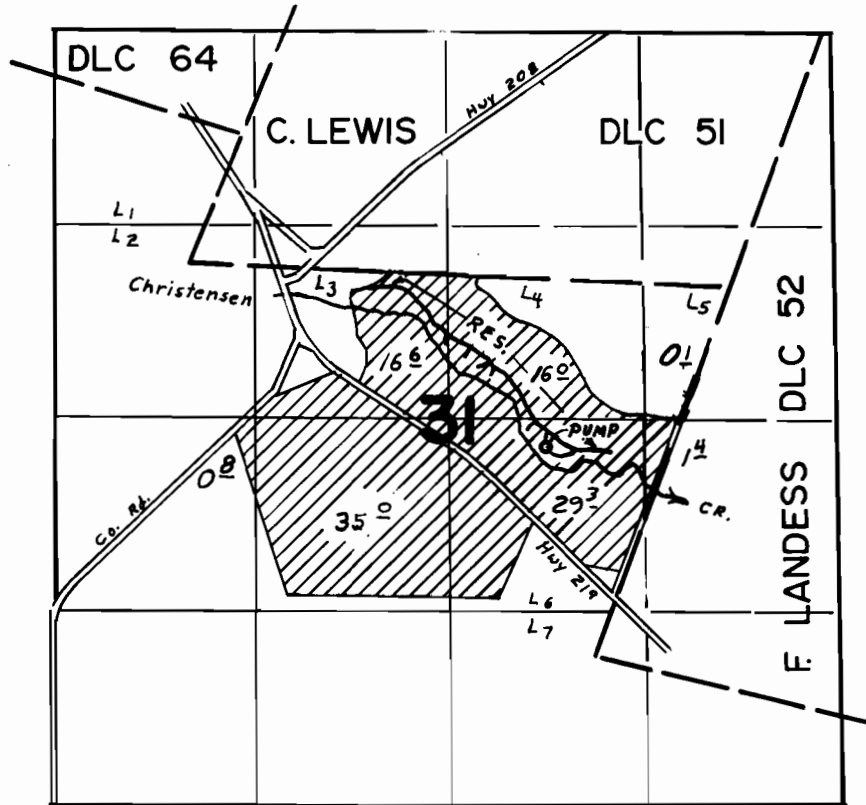

Pump Loc. 200'S. & 670'E. From Center Sec. 31

FINAL PROOF SURVEY UNDER

R-49265 R-6159
Application No. 49266... Permit No. 38077...
IN NAME OF

OREGON BERRY PACKING CO.

Surveyed JUNE 22 1978., by S. R. APPELEGATE